

U.S. PUBLIC LAND SURVEY MONUMENT LOCATION RECORD

Recorders Data

CORNER: East MC SECTION: 12 TOWNSHIP 38 NORTH RANGE 9 EASTWEST

FOR M.C. CORNER INDICATE: NAME OF WATERWAY Sugar Camp Lake SECTION LINE North

(CITY)(VILLAGE)(TOWN) OF: Sugar Camp COUNTY OF: Oneida

Additional Reference: Plat of Survey No. B-269 Oneida County survey records.


Description of monument found or placed and all other evidence used as a basis for monument location; including all monuments and related measurements required if the corner location is reestablished by lost corner proportionate methods. Also indicate name of original surveyor, survey date, corner monument set and established bearing trees, witness or reference monuments with ties from available records.

A thorough records and field evidence search revealed that the original concrete monument with stamped tablet in top by 1956 BLM Re-Survey had obviously been moved South by someone; primarily as indicated by reference record distance and bearing from the original BLM BTs still existing and plainly marked. I also verified that monument had been moved by a field traverse comparison to iron pipe monuments of record survey per Plats of Survey L-857, B-291 and B-2533 filed in Oneida County records, which were referenced by bearing and distance to the original BLM monument location from 1974 to 1992. Therefore, upon such basis and a field inspection concurrence with Oneida County Surveyor Romportl, I reestablished the original MC location by BLM in 1956 with a standard 2" dia. by 30" long aluminum pipe monument with a stamped Oneida Co. cap 6" below existing lake sand beach grade, by a best fit reference to the record BLM BTs and record survey monuments found. I also left the moved 6" dia. concrete monument found with standard BLM tablet in top flush with existing grade as a Witness Monument to the reset MC monument North 7.30 feet at 'A' in location diagram below.

In 1863, Daugherty/GLO set a wood post as the original MC and marked an OBT 12" Pw S71°E at 491ks and noting no other tree near. In 1956, Crawford/BLM during his Resurvey noted he reset the original MC from the original SE GLO OBT, which he found as a rotted 16" Pw stump, but which is now obliterated or beyond usage evidence for positioning purposes.

I nailed a standard BT sign tag to West face of BLM BT found as Witness No. 3 below. This recovery completed on September 22, 1998; and also witnessed by adjoining owners.

Plan view map of monument location with bearing and distance ties to a minimum of four(4) described witness or reference monuments of concrete, natural stone, iron, live bearing trees or equivalent material. If applicable, also show a minimum of two(2) bearing and distance ties to any other monument found and not accepted; including the bearing and distance from the accepted monument. Indicate the basis for bearings of reference ties if not referenced to magnetic north.

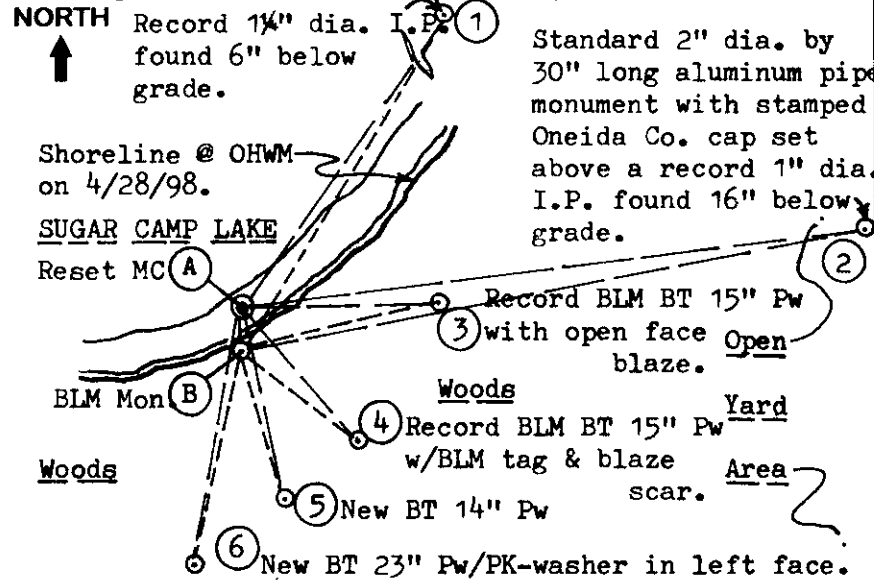

WITNESS MONUMENT TIES:

- A - B South 7.30'.
- A - 1 N34°32'14"E 98.15'.
- 2 N85°22'11"E 98.49'.
- 3 S88°E 30.49'.
- 4 S41°E 27.23'.
- 5 S12°E 30.50'.
- 6 S11°W 40.76'.
- B - 1 N32°15'43"E 104.25'.
- 2 N81°10'10"E 99.35'.
- 3 N78°E 30.79'.
- 4 S54°E 22.06'.
- 5 S15°E 23.34'.
- 6 S14°W 33.62'.

Note: I stamped BLM monument tablet 'MC 7.3 FT NORTH'.

Note: Standard white poly 'T' marker post set along SE side of BLM concrete monument at 'B'.


SCALE: 1" = 30'

Unless otherwise indicated, all bearing tree ties are to a .25" dia. by 2.5" long PK nail with a 1.25" dia. steel washer driven into unblazed right face and a .25" dia. by 2.5" long PK nail with a 2" dia. steel washer stamped 'BT' is also driven into unblazed face of bearing tree at DBH; the basis for measured bearings is magnetic to nearest degree and all tie distances are horizontal measure to nearest 1/100th feet.

LAND SURVEYOR CERTIFICATION:

I, William C. Rohde, hereby certify that I am a duly licensed Professional Land Surveyor in Wisconsin, that this USPLS monument location was determined by me or under my direction and control, and that this U.S. Public Land Survey Monument Location Record is true and correct to the best of my knowledge and belief.

William C. Rohde Date: 9-27-98
Signature

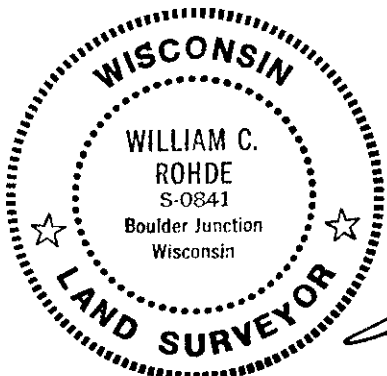

RLS SEAL

SHEET NO. 1 OF 1

This form is intended to fulfill requirements of Chapter A-E 7.08 (3)(a)(b)(c)(d)(e)(f)(g)(h)(i) U.S. Public Land Survey Monument Location Record, Wisconsin Administrative Code. Use reverse side for geodetic location data and/or continuation purposes.

		12	

SECTION LOCATION MAP

INDEX NO. E 24-25

3809010009

INDEX NO. E 24-25