U.S. PUBLIC LAND SURVEY MONUMENT RECORD

Note: This form is intended and designed to fulfill all requirements of Wisconsin Administrative Code, Chapter A-E 7.08 U.S Public Land Survey Monument Record (3) (a) (b) (c) (d) (e) (f) (g) (h) (i). An additional sheet may be added if necessary to conform with said requirements.

(a) Corner location: Township 35 North

Range 9 East/~~West~~

Town/City/Village Enterprise

County Oneida

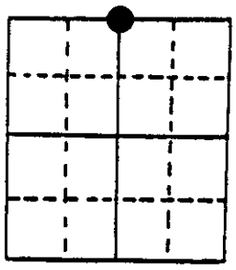

Section 24

(b) (f) (g) (h) Description of monument found at this corner and if it was accepted, state all evidence (material, testimonial, occupational, plats, records, other monuments) used as a basis for accepting. If not accepted or if nothing was found, state evidence used as basis for establishing location. If reestablished through lost corner proportionate methods, indicate all monuments, distances and directions used to establish. Indicate type of monument found or set and sign post.

1864 - James Nowlin established this corner and set a wood post with two BTs:
8" Tamarack, N6°W, 39 Links 8" Tamarack, N78°E, 32 Links

Unknown Date - Dorr restored corner by lost method and set stake and two BTs:
4" Tamarack, N84 1/2°W, 17 1/2 Links 3" Spruce, N89°E, 15 Links

5/25/1936 - Maine confirmed Dorr's position and found it to be substantially correct and placed a 2 1/4" x 60" iron pipe with brass cap. No BTs available.

1/7/1990 - Milo E. Stefan found Maine's monument in fair condition with 5" x 5" squared cedar stake along side. Dorr's BTs gone. We made new BTs and placed plastic sign post.

(c) (d) (e) Plan view of corner with ties to at least 4 witness monuments. If in disagreement with previously established corner, show the distances between the two corners and also indicate the ties to the disputed corner.

1) 2 1/4" x 60" Iron pipe/brass cap
2) 2" Black Spruce, N52°E, 38.00'
3) 3" Tamarack, S13°E, 62.52'
4) 4" Tamarack, S27°W, 78.68'
5) 6" Tamarack, S65°W, 43.27'
6) Plastic sign post next to monument

Distances to nail in side of BTs
Stump blazes scribed "BT"

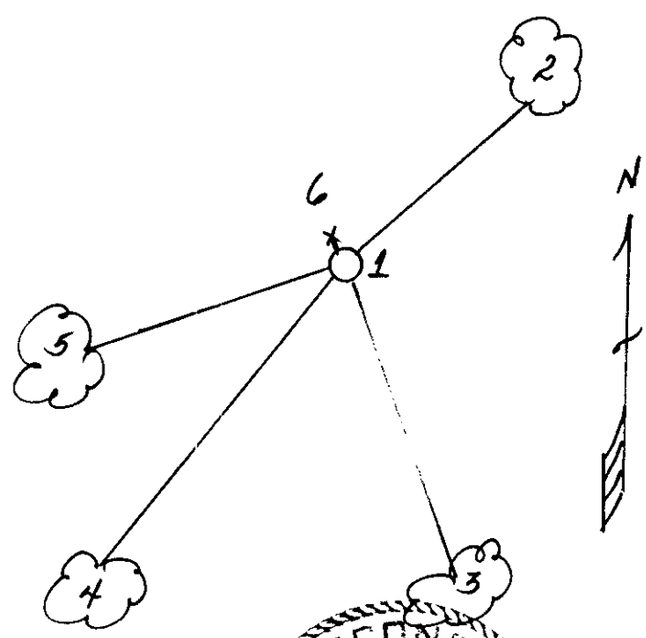

(i) I, Milo E. Stefan (type or print name) certify that the corner location on this record was determined by me or under my direction and control and that this U.S. Public Land Survey Monument Record is correct and complete to the best of my knowledge and belief.

Milo E. Stefan 1/10/90

Signature Date

WISCONSIN MILO E. STEFAN S-1248 RHINELANDER, WIS. LAND SURVEYOR

Stamp

Index No. N-23