CERTIFIED LAND CORNER RESTORATION

Index No. E-20

State of Wisconsin
County of Oneida } ss.

I Philip P. Hansen, do hereby certify that on the 13th day of October, 1976, I found evidence of the C 1/16 corner of Section 2, 11, Township 35, North, Range 11 East, Fourth Principal Meridian, as described hereon; and that from this evidence I established a new monument and accessories as described hereon to perpetuate the original location of this corner.

Resident witnesses:

[illegible]

[illegible]

[illegible]

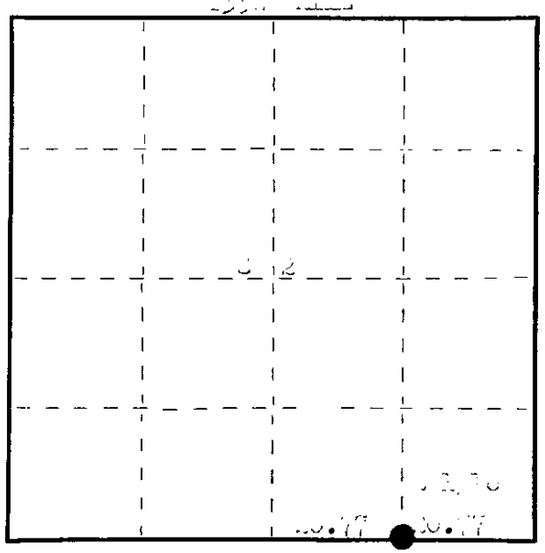

○ = Corner monument restored.

History of original corner establishment:

Original established by F.C. Lawrence, Registered Land Surveyor, in 1954. [illegible] random line N 00° [illegible] recovered section corner [illegible] at [illegible].08 chains. Closed [illegible] 1.98 ch. [illegible] north of section corner 1, [illegible] set [illegible] post.

Description of corner evidence found:

Recovered 4" round post, [illegible] corners. [illegible] on [illegible] sides. [illegible] visible. [illegible] post [illegible] ct. [illegible] recovered.

Description of monument and accessories I established to perpetuate the original location of this corner.

[illegible] brass cap [illegible] on top [illegible] 4" [illegible], set [illegible] 1.

[illegible] 1, set [illegible].

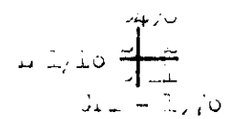

Dated at [illegible], Wis., this [illegible] day of November, 1976

Signature Philip P. Hansen Title [illegible] Registration No. [illegible]
(County Surveyor, Registered Land Surveyor, or other duly authorized official)

Office of Register of Deeds, County of Oneida, I hereby certify that the within instrument was filed in this office for record on the 7th day of December, 1976 at 11:00 o'clock A. M.

Doris Verage Kuehn
(Register of Deeds)

By Joseph M. Boomer Deputy

FORM 985

351102 0010