CERTIFIED LAND CORNER RESTORATION

Index No. F-5

State of Wisconsin
County of Oneida } ss.

I Philip T. Hansen, do hereby certify that on the 9th day of November, 19 76, I found evidence of the N 1/16 corner of Sections 7 & 8 Township 35, North, Range 11 East, Fourth Principal Meridian, as described hereon; and that from this evidence I established a new monument and accessories as described hereon to perpetuate the original location of this corner.

Resident witnesses:

Cle[illegible] [illegible]arker

Jim Claflin

Herb [illegible]oner

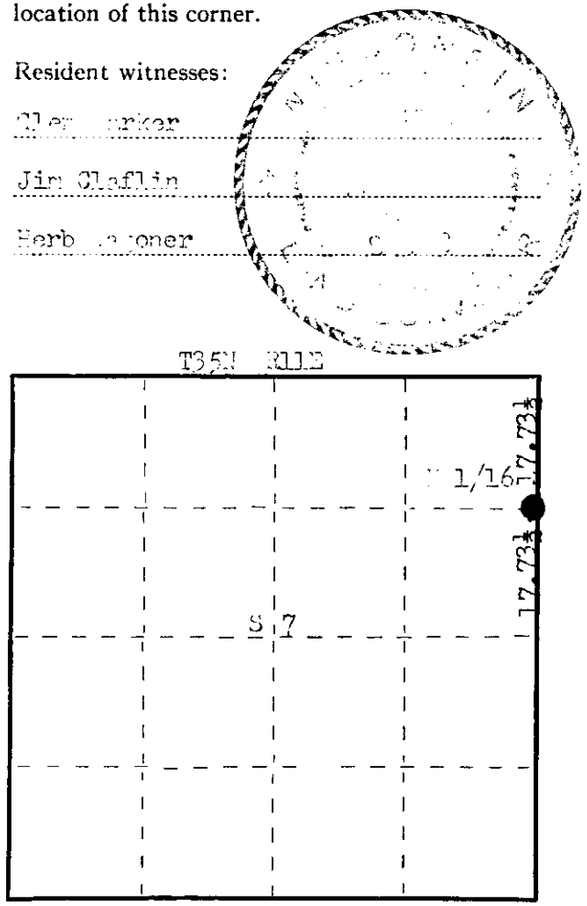

○ = Corner monument restored.

History of original corner establishment:

H.O. Lar[illegible]ce, [illegible]gistered Land Surveyor, ran a [illegible] line clo[illegible] on old cut out line [illegible] 14½° fro[illegible] iron pipe recovered at 1/4 corner between Sec. 7 and 8, 35.[illegible]7 chains to close out 3 lines west of Section Corner. At 17.73 chains he found so[illegible]one's [illegible] 1/16 corner 16 links east. [illegible]set [illegible] 1/16 corner at 17.73 chains on line, intermediate.
Marked BTs – White Birch 9" [illegible] 30° [illegible] 30 links.
Cedar stump 10" [illegible] 60° [illegible] 31[illegible] links.

Description of corner evidence found:

Recovered 6" cedar post, squared and scribed S7, [illegible] 1/16 S8 in fair condition.

Recovered BT – White Birch 9" (11") [illegible] 30° [illegible] 30 links (32 links), scribed S7 BT.
Cedar stump 10" [illegible] 60° [illegible] 30.5 links, scribed S8 BT.

Description of monument and accessories I established to perpetuate the original location of this corner.

Replaced 6" cedar post with 1½" (O) iron pipe with brass cap, stamped:

Monument projects 2' above ground.
BT – Cedar 6" [illegible] 10° [illegible] 36.8 links, scribed 1/16 BT.
Placed a rock cairn around base of monument.

S-498
T35N R11E
N 1/16 7 | 8
CPI-1976

Dated at Rhinelander, Wis., this 1st day of December, 1976

Signature ..... Title Registered Land Surveyor Registration No. S-493
(County Surveyor, Registered Land Surveyor, or other duly authorized official)

Office of Register of Deeds, County of Oneida, I hereby certify that the within instrument was filed in this office for record on the 9th day of December, 1976 at 2:00 o'clock P. M.

Doris Verage Kuehn
(Register of Deeds)

By Joseph M. Boomer Deputy

FORM 985

351107300 0