

This form is intended to fulfill the requirements of Chapter A-E 7.08 (3)(a) thru (i) U.S. Public Land Survey Monument Location Record, Wisconsin Administrative Code. Use the reverse side of form for continuation.

Recorders Data

U.S. PUBLIC LAND SURVEY MONUMENT LOCATION RECORD

USPLS CORNER: NORTH 1/4 CORNER SECTION: 25 TOWNSHIP: 36 NORTH RANGE: 09 EAST

NAME OF WATERWAY FOR M.C. CORNER: N/A SECTION LINE: N/A

(CITY)(VILLAGE)(TOWN) OF: PELICAN COUNTY OF: ONEIDA

Description of monument found or placed and all other evidence used as the basis for monument location; including monuments and related measurements required if the corner location was reestablished by lost corner proportionate methods. Also indicate name of original surveyor, original survey date and the corner monument, bearing trees, witness or other reference monuments established; including measured bearing and distance ties, from available records.

Found and accepted an older 1.5" dia. galvanized iron pipe with loose stamped cap 22" above grade and tipped SE about 15°. I removed the 48" long pipe monument to reveal the plumb soil cavity below grade and reset the corner with a 2" dia. by 30" long standard aluminum monument with stamped Oneida County cap 8" above grade and secured by tamping for new ties. I left the old corner pipe monument flat on grade nearby.

In August 1865, William E. Daugherty/GLO set a wood post as the original corner and marked new OBT: 14" Aspen N73°E 6 links only as he noted no others near; all now obliterated.


In 1969, George Drivas of Regis Paper Company notes a monument at this corner by Rhinelander Paper Company per Plat of Survey L-254 in Oneida County survey records; monument found presumably set by the latter paper company.

In March 1992, Milo E. Steffan/RLS 1558 notes "Found restored GLO corner" per Plat of Survey B-2396 in Oneida County survey records; Steffan undoubtedly tied corner to older BTs I found, but has filed no USPLS Location Record to date.

Steffan's 1992 survey was completed for adjoining owner Roland Rueckert, whom I met in the field this date and he walked me to this corner location with capped iron pipe, which he identified had been used by Steffan as the North 1/4 corner of Section 25 during his survey.

This recovery completed November 2, 2001.

Plan view map of monument location with bearing and distance ties to a minimum of four(4) described witness or reference monuments of concrete, natural stone, iron, live bearing trees or equivalent material. If applicable, also show a minimum of two(2) bearing and distance ties to any other monument found and not accepted; including the bearing and distance from the accepted monument.

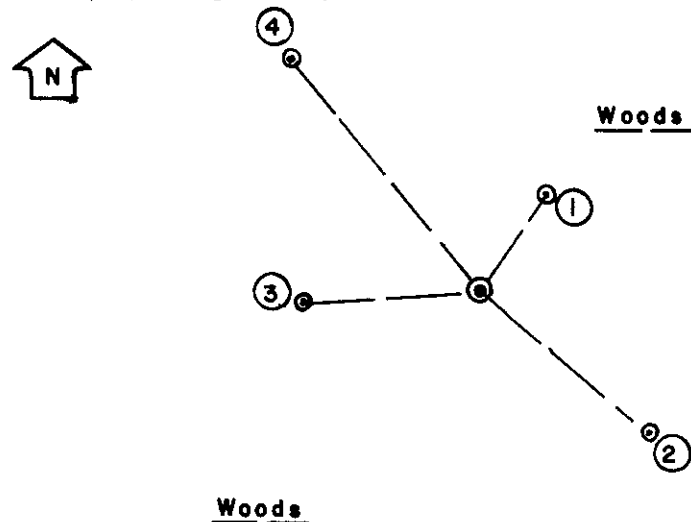

WITNESS MONUMENT TIES:

- ① - Old BT 9" Pw with long lower face blaze open and scribed N35°E 12.05'.
- ② - Old BT 12" Pr with upper & lower blaze scars S50°E 23.21'.
- ③ - Old BT 12" Pw with lower blaze open and upper blaze scar plain S87°W 18.28'.
- ④ - Old BT 12" Pw with upper & lower blazes open & scribed N40°W 31.41'.


Older BTs found not of public record and a 20d aluminum nail found in right face of all BTs were not used for ties.

Standard white poly 'T' corner marker post set 3" South of corner monument.

SCALE: 1" = 20'

Unless otherwise indicated, all bearing tree ties are to a .25" dia. by 2.5" long PK nail with a 1.25" dia. steel washer driven into unblazed right face and a .25" dia. by 2.5" long PK nail with a 2" dia. steel washer stamped BT is also driven into unblazed face of bearing tree at DBH; the basis for measured bearings is by compass to nearest degree and all tie distances are measured horizontal by steel tape corrected to nearest 1/100th feet at standard temperature of 68° F.

RLS SEAL:

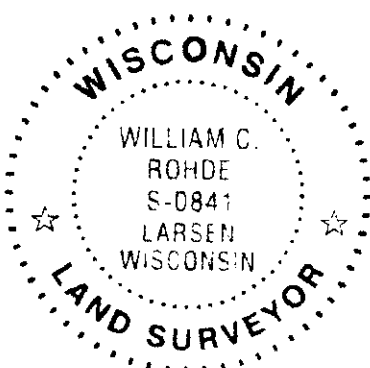


LAND SURVEYOR CERTIFICATE:

I, William C. Rohde, hereby certify that I am duly licensed as a Professional Land Surveyor in the State of Wisconsin; that this USPLS monument location was determined by me and/or under my direct supervision and control; and that this U.S. Public Land Survey Monument Location Record is true and correct to the best of my knowledge and belief.

Signed: *William C. Rohde*
William C. Rohde RLS 841

Date Signed: March 25, 2002

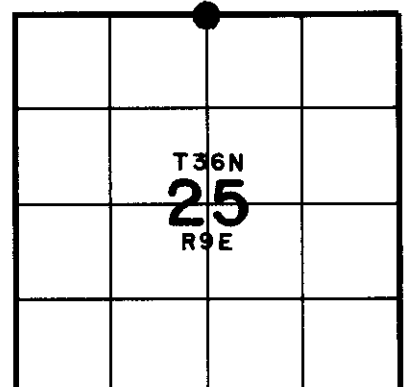

SECTION LOCATION MAP
INDEX NO. R 25

US PUBLIC LAND SURVEY MONUMENT RECORD

Per Wis. Admin. Code § A-E 7.08, a U.S. public land survey monument record shall be prepared and filed with the county survey records as part of any land survey within 60 days of setting or accepting the corner, which includes or requires the perpetuation, restoration, or use of a U.S. public land survey corner and when any of the situations in Wis. Admin. Code § A-E 7.08(1)(a), (b) or (c) arise.

3(a) Corner Identification:


Found an Oneida County aluminum monument
 South 1/4 Corner
 Section 24
 Township 36 North
 Range 9 East
 4th Principal Meridian
 Town of Pelican
 Oneida Co., WI

Observed Coordinates:

N: 145757.06
 E: 289447.15
 Datum: NAD83(2011)
 GNSS Control: WISCRS VRS
 GNSS Method: RTK-Direct
 Verification Method: 2

CORNER ID:

3609240020

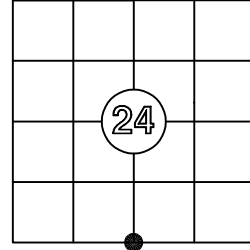

Establishment of Original Corner

Corner Set: Wood Post
 Original Surveyor: Wm. Daugherty
 Date of Survey: August, 1865
 Aspen, 14", N 73° E, 6 links
 No others near

The coordinate value has been verified by at least one of the following methods:

1. Comparison to a previously determined GNSS determined published value;
2. The value is the average of two or more GNSS observations at markedly different times;
3. One or more distances were measured to the corner from offset GNSS observed locations, set and observed per No. 2 methods.


3(b)(c)(d)(f)(g)(h)

This is a continuation of a previous USPLSS Monument Record by Surveyor William Rohde, S-841 (2002). See previous record for additional history on this corner.


- Rohde's monument record of March 25, 2002 states he set an Oneida County aluminum, projecting 8" above ground.
- 11/21/2002 - Kevin Bixby, S-2343, finds an Oneida County aluminum monument.
- 4/3/2003 - Kevin Bixby, S-2343, finds an Oneida County aluminum monument.
- 5/24/2025 - I, Anthony Jones, S-2508, found the Oneida County aluminum monument, as described by Rohde and others. All witnesses are shown below. The monument is 8" above grade, in good condition and stamped to show the location. There is a white poly "T" post 0.25' south of the monument.

WITNESS MONUMENT TIES

1. 10" white pine (found): N 35° E, 12.05'. Blaze in face of the tree and scribing is visible. I found a PK nail/washer 48" above grade, facing the monument, and at grade in the side of the tree. I set new nail above the lower PK nail to pull distance.
2. 15" red pine (found): S 50° E, 23.15'. Blazes have grown shut. I found a PK nail/washer 48" above grade, facing the monument, and at grade in the side of the tree. I set a new nail above the lower PK nail to pull distance.
3. 18" white pine (found): S 87° W, 18.31'. Blazes have grown shut. I found a PK nail/washer 42" above grade, facing the monument, and at grade in the side of the tree. I set a new nail above the lower PK nail to pull distance.
4. 15" white pine (found): N 40° W, 31.45'. Blazes have grown shut. I found a PK nail/washer 44" above grade, facing the monument, and at grade in the side of the tree. I set a new nail above the lower PK nail to pull distance.

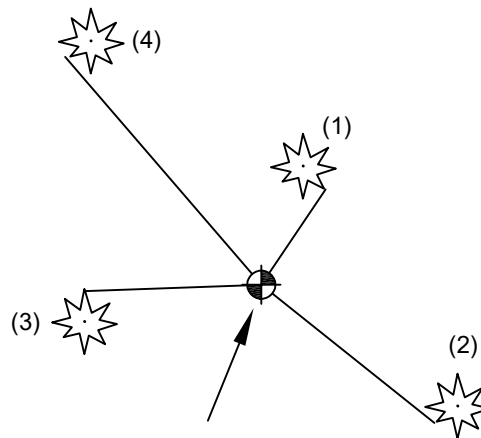

SOUTH 1/4 CORNER
 SECTION 24-36-09
 FOUND ONEIDA COUNTY
 ALUMINUM MONUMENT

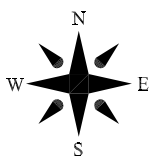

Scale: 1"=20'

Bearings magnetic

3(i) I, Anthony R. Jones, Wisconsin Professional Land Surveyor No S-2508, hereby certify that the corner location shown on this record was determined by me, and that this U.S. Public Land Survey Monument Record is correct and complete to the best of my knowledge and belief.

