CERTIFIED LAND CORNER RESTORATION

Index No. N-18

State of Wisconsin
County of Oneida } ss.

I Philip T. Hansen, do hereby certify that on the 22nd day of July, 19 75, I found evidence of the W-1/16 corner of Sections 14 and 23 Township 36, North, Range 10 East, Fourth Principal Meridian, as described hereon; and that from this evidence I established a new monument and accessories as described hereon to perpetuate the original location of this corner.

Resident witnesses:

WISCONSIN PHILIP T. HANSEN ARGONNE, WIS. S-498 LAND SURVEYOR

T36N R10E

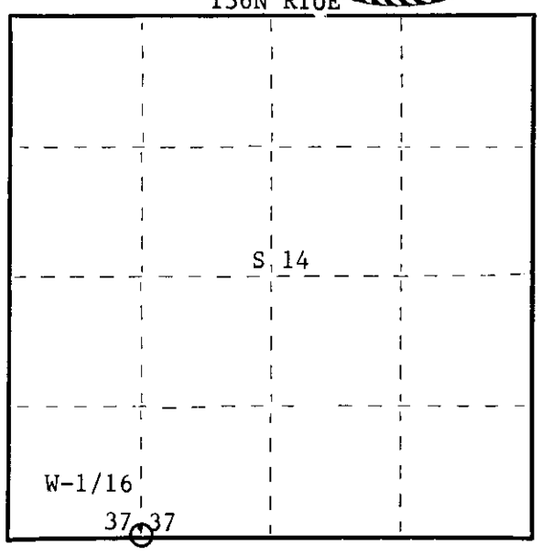

O = Corner monument restored.

History of original corner establishment:
Corner established by D.H. Vaughan, County Surveyor, in 1910 from which cedar 5" bears S2°E 21 links and cedar 5" bears N81°E 12-1/2 links. Corner recovered by H.C. Lawrence, Registered Land Surveyor. Found old post and both of the BT's.

Set new cedar post and made NBT's - cedar 10" bears S39°E 36-1/2 links and white birch 14" bears N27°E 31 links.

Description of corner evidence found:
Recovered 4" cedar post, squared and scribed W-1/16 S14, W-1/16 S23 in good condition. Also, a piece of Vaughan's old cedar post lying on the ground.

Recovered OBT -	Cedar 5" (6")	S 2°E	21 links (21.5 links) scribed 1/8S.
	Cedar 5" (7")	N81°E	12.5 links scribing grown over.
	Cedar 10"	S39°E	36.5 links now cut-off stump - scribed NBT.
	White birch 14"	N27°E	31 links now cut-off stump - scribed NBT.

Description of monument and accessories I established to perpetuate the original location of this corner.
Replaced 4" cedar post with 1-1/2" O.D. iron pipe with 2" brass cap stamped -

NBT -	Cedar 6"	S35°W	52.3 links scribed 1/16 BT.
	Cedar 5"	S12°E	21.8 links scribed 1/16 BT.

S498
T36N R10E
S 14
W-1/16
CPI-1975

Dated at Rhinelander, Wis., this 24th day of July, 19 75

Signature Philip T. Hansen Title Registered Land Surveyor Registration No. S-498
(County Surveyor, Registered Land Surveyor, or other duly authorized official)

Office of Register of Deeds, County of Oneida I hereby certify that the within instrument was filed in this office for record on the 1st day of October 1975 at 3:00 o'clock P. M.

Doris Verage Kuehn
(Register of Deeds)

By ..... Deputy

FORM 985 H. C. MILLER CO., MILWAUKEE

36014 0030