U.S. PUBLIC LAND SURVEY MONUMENT RECORD

Note: This form is intended and designed to fulfill all requirements of Wisconsin Administrative Code, Chapter A-E 7.08 U.S. Public Land Survey Monument Record (3)(a-i).

(a) CORNER LOCATION
1/4 Cor. of Secs. 5 & 32
Township 36 & 37 North
Range 5 East of the 4th P.M.
Town of Little Rice
County of Oneida

WISCRS - Oneida County
N: 167,525.29 USft
E: 141,766.97 USft
Datum: NAD 83(2011)
GNSS Method: RTN - Direct
GNSS Control: WISCORS VRS

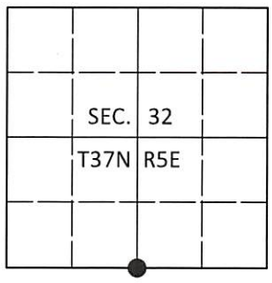

(b) HISTORY OF ORIGINAL CORNER ESTABLISHMENT

Original Surveyor: Alfred Millard

Original Accessories:

Date of Survey Commenced: Aug., 1860
Completed: Sep., 1860

W. Pine 20" N60°W, 14 lks.
W. Pine 20" S70°E, 19 lks.

(b)(f)(g)(h) Description of monument found at this corner and if it was accepted, state all evidence (material, testimonial, occupational, plats, records, other monuments) used as a basis for accepting. If not accepted or if nothing was found, state evidence used as basis for establishing location. If re-established through lost corner proportionate methods, indicate all monuments, distances and directions used to establish. Indicate type of monument and sign post found or set.

Aug. 30, 2020: I found and accepted a monument not of record, a 2.4" diam. iron pipe with a 2.4" diam. WCD brass cap projecting 16" above the ground surface. I was unable to recover evidence of the GLO bearing trees, but this monument is identical in character to those used by John H. Fisher on the North line of Sec. 4. I found or established accessories as shown below. I set a white vinyl sign post bearing SE, 0.7 ft.

The coordinate value shown has been verified by at least one of the following methods: 1) comparison to a previously GPS determined published value; 2) the value is the average of two or more GPS observations at a markedly different time; 3) one or more distances were measured back to the GPS observed corner from temporary GPS observed offset locations.

(c)(d)(e) Plan view of corner with ties to at least 4 witness monuments. If in disagreement with previously established corner, show the distances between the two corners and also indicate the ties to the disputed.

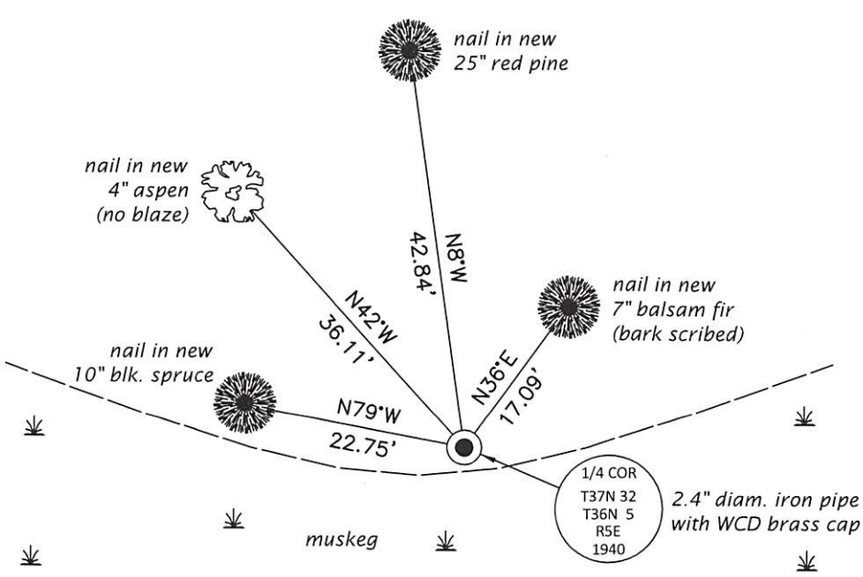

WISCONSIN
JEFFREY W. AUSTIN
S-1885
MINOCQUA, WIS.
LAND SURVEYOR

REGISTER OF DEEDS OFFICE
ONEIDA COUNTY
FILED
JAN 13 2021
KYLE J. FRANSON
REGISTER OF DEEDS

(i) I, Jeffrey W. Austin, Professional Land Surveyor No. S-1885, hereby certify that the corner location on this record was determined by me or under my direction and control and that this U.S. Public Land Survey Monument Record is correct and complete to the best of my knowledge and belief.

Signature 15 DEC 2020 Date

3705320020 (INDEX NO. Z-7)