

U.S. PUBLIC LAND SURVEY MONUMENT RECORD

Note: This form is intended and designed to fulfill all requirements of Wisconsin Administrative Code, Chapter A-E 7.08 U.S. Public Land Survey Monument Record (3)(a-i).

(a) CORNER LOCATION
 Cor. of Secs. 14, 15, 22 & 23
 Township 37 North
 Range 7 East of the 4th P.M.
 Town of Cassian
 County of Oneida

WISCORS - Oneida County
 N: 183,207.48 USft
 E: 218,371.58 USft
 Datum: NAD 83(2011)
 GNSS Method: RTN - Direct
 GNSS Control: WISCORS VRS

	SEC. 15		
	T37N	R7E	

(b) HISTORY OF ORIGINAL CORNER ESTABLISHMENT

Original Surveyor: Joseph H. Jenkins

Original Accessories:

Date of Survey Commenced: Nov. 3, 1862
 Completed: Nov. 15, 1862

Tamarack 7" N36°W, 48 lks.
 Tamarack 8" N67°E, 78 lks.
 Tamarack 6" S27°E, 76 lks.
 Spruce 5" S39°W, 46 lks.

(b)(f)(g)(h) Description of monument found at this corner and if it was accepted, state all evidence (material, testimonial, occupational, plats, records, other monuments) used as a basis for accepting. If not accepted or if nothing was found, state evidence used as basis for establishing location. If re-established through lost corner proportionate methods, indicate all monuments, distances and directions used to establish. Indicate type of monument and sign post found or set.


June 13, 1936: On page 125 of Maine book 1, V.M. Maine sets official iron post identified by remains of the GLO tamarack bearing trees and wood post point. He marked new: w. pine stp. 28 N29°E, .85; tam. 5 N6°W, .57 (Note: see page 103 of Maine's 1936 book. This should be 67 links.)

Oct. 28, 1975: On OCS Map. No. B-891, James D. Rein, PLS recovered Maine's 2" brass capped iron pipe, his pine stump, and his tamarack.

May 15, 2020: I found and accepted the record monument, a 2.4" diam. iron pipe with a 2.4" diam. brass cap projecting 15" above the bog surface. I found or established accessories as shown below. I found a white vinyl sign post bearing South, 0.9 ft.

The coordinate value shown has been verified by at least one of the following methods: 1) comparison to a previously GPS determined published value; 2) the value is the average of two or more GPS observations at a markedly different time; 3) one or more distances were measured back to the GPS observed corner from temporary GPS observed offset locations.

(c)(d)(e) Plan view of corner with ties to at least 4 witness monuments. If in disagreement with previously established corner, show the distances between the two corners and also indicate the ties to the disputed.

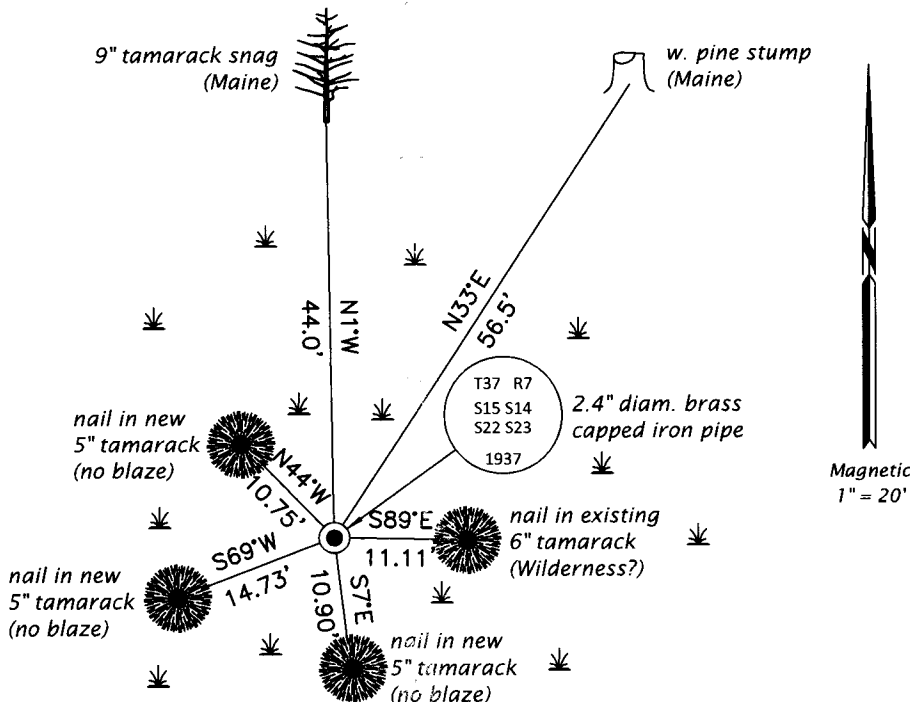

REGISTER OF DEEDS OFFICE
 ONEIDA COUNTY
 FILED

JUN 26 2020

KYLE J. FRANSON
 REGISTER OF DEEDS

(i) I, Jeffrey W. Austin, Professional Land Surveyor No. S-1885, hereby certify that the corner location on this record was determined by me or under my direction and control and that this U.S. Public Land Survey Monument Record is correct and complete to the best of my knowledge and belief.

[Handwritten Signature]
 Signature

JUNE 5, 2020
 Date