

CERTIFIED LAND CORNER RESTORATION

Index No. **E-21**

State of Wisconsin

County of **Oneida** } ss.

I **Phillip T. Hansen**, do hereby

certify that on the **3rd** day

of **December**, 19**76**, I found

evidence of the **Section**

corner of **1, 2, 11 & 12**

Township **37**, North, Range

**9 East**, Fourth Principal Meridian,

as described hereon; and that from this evidence

I established a new monument and accessories


as described hereon to perpetuate the original

location of this corner.

Resident witnesses:

**Jim Claflin**

**Herb Wagoner**

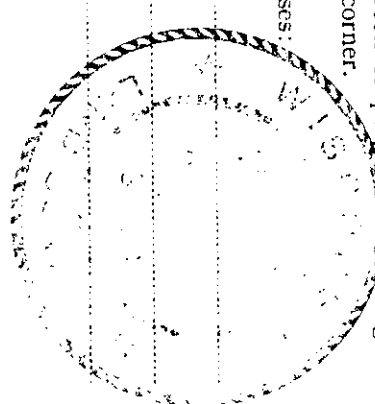


History of original corner establishment:  
Original corner established by Wm. E. Dougherty, Deputy Surveyor, in 1863, from which  
White Pine 10" bears N 54° W 25 links and Yellow Pine 8" bears S 67° E 35 links.  
Corner recovered by B.F. Dorr, County Surveyor, in 1894.  
Corner re-established by N. Loftus, Ripco Surveyor, in 1956. Set an iron pipe in road  
bed of Old 17, according to Dorr's chainage. Marked corner also with 1" iron pipe with  
brass cap.

Description of corner evidence found:  
Recovered Ripco's 1" OD iron pipe with 2" square brass cap. Also recovered 1" I.P. beside  
the monument driven flush with ground.  
Recovered Black Spruce 6" S 70° E 44.7 links, scribed, but not legible.

Description of monument and accessories I established to perpetuate the original location of this corner.  
As monument was found in good condition, it was left in place, cap stamped:  
Monument projects 28" above ground.  
NBRTs - Black Spruce 6" S 36° W 26.7 links, scribed BT.  
Black Spruce 8" S 8° E 51.3 links, scribed BT.

T37N B9E  
211  
1112  
RIPCO

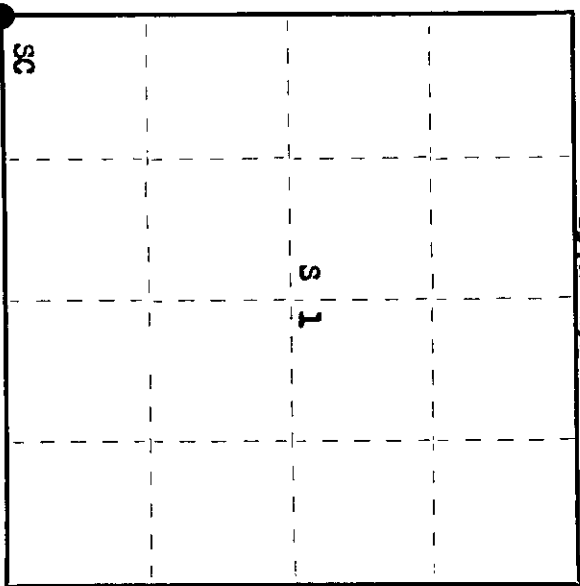

○ = Corner monument restored.

Dated at **Rhinelander**, Wis., this **22nd** day of **December**, 19**76**

Signature *Phillip T. Hansen* Title **Registered Land Surveyor** Registration No. **S-498**  
(County Surveyor, Registered Land Surveyor, or other duly authorized official)

Office of Register of Deeds, County of **Oneida**, I hereby certify that the within  
instrument was filed in this office for record on the **16th** day of **February**, 19**77**  
at **10:00** o'clock **A**. M.

*Stacie Neugebauer*  
(Register of Deeds)

By *Joseph W. Betts* Deputy

3709020000