
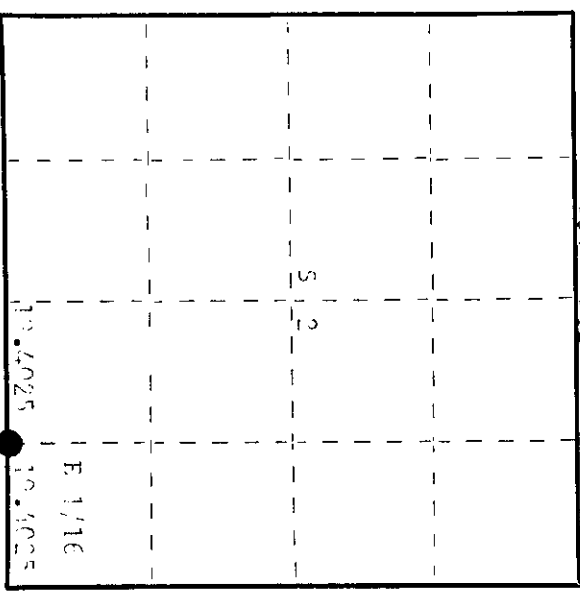


State of Wisconsin

County of Oneida } ss.

I, Phillip T. Hansen, do hereby certify that on the 10th day of September, 1977, I found evidence of the E 1/16 corner of Section 2 & 11 Township 37, North, Range 9 East, Fourth Principal Meridian, as described hereon; and that from this evidence I established a new monument and accessories as described hereon to perpetuate the original location of this corner.

Resident witnesses:  
Mr. Claffin  
Herb Tragonec

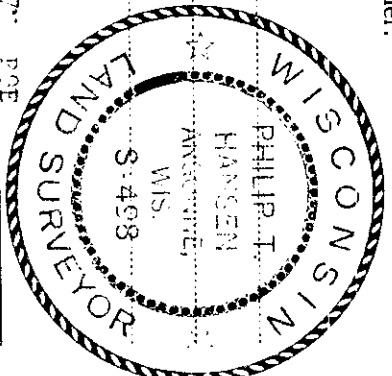

○ = Corner monument restored.

History of original corner establishment:

Corner established by Drivers and crew, Pipeco Surveyors, in 1922. Fan Range line S 87° 33' 40" W a distance of 27.88 chains, deflected right 171° 49' 50" a distance of .935 chains to S 1 1/4 corner. Computed distance 38.705 chains at bearing S 87° 45' 30" W. Set E 1/16 interredible at 10.4025 chains.

Description of corner evidence found:

Recovered 1st Iron pipe with a 2nd brass cap, projecting 3/4" above ground. Cap stamped: Monument recovered in good condition. Also recovered an old square cedar post, 12" x 6" x 24" (Hwy), scribed 1/2" - 1/2", with old barometer scribbled 1/2" W 17' 10" (Hwy) S 70° W 20' 11" (Hwy). 

Description of monument and accessories I established to perpetuate the original location of this corner. Monument was left as recovered. No additional accessories established.

Dated at Amherst, Wis., this 23rd day of September, 1977.

Signature Phillip T. Hansen Title Registered Land Surveyor Registration No. S-498  
(County Surveyor, Registered Land Surveyor, or other duly authorized official)

Office of Register of Deeds, County of Oneida. I hereby certify that the within instrument was filed in this office for record on the 12th day of October, 1977 at 9:15 o'clock A. M.

Dorcas Bergey Kuehn  
(Register of Deeds)

By: \_\_\_\_\_ Deputy