

CERTIFIED LAND CORNER RESTORATION

Index No. **E-18**

State of Wisconsin

County of Oneida } ss.

I Phillip T. Hansen, do hereby certify that on the 21st day of January, 1977, I found evidence of the W 1/16 corner of Section 2 & 11


Township 37, North, Range 9 East, Fourth Principal Meridian,

as described hereon; and that from this evidence I established a new monument and accessories as described hereon to perpetuate the original location of this corner.


Resident witnesses:

Jim Claflin

Herb Wagoner

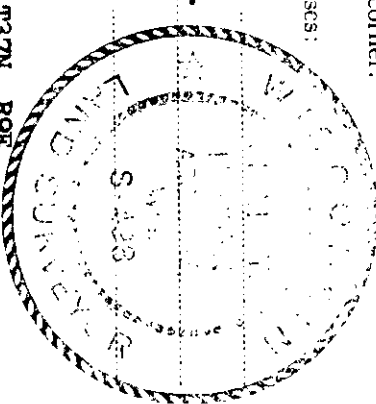

T37N R9E

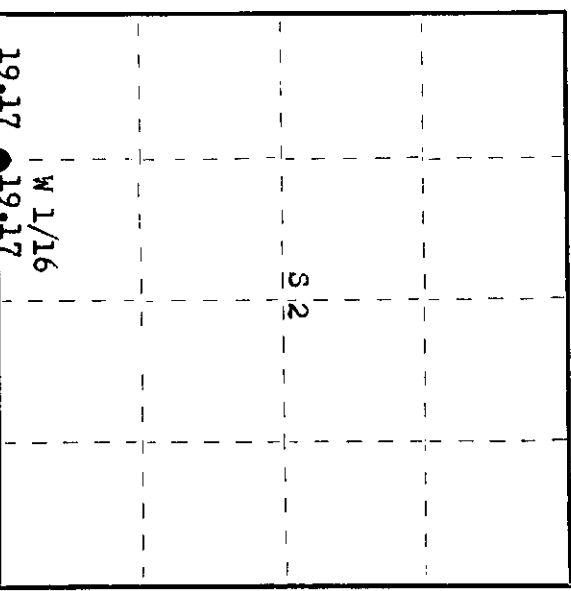

○ = Corner monument restored.

History of original corner establishment:

Corner established by B.F. Dorr, County Surveyor, in 1894. Set corner at 19.17 chains east of Corner 2, 3, 10 & 11. Corner re-established by N. Loftus in 1956. Recovered stump of Dorr's cedar, with 8 scribbing still visible. Set 1" iron pipe with brass cap and marked NBT - Tamarack 6" S 22° E 27 1/2 links.

Description of corner evidence found:

Recovered 1" iron pipe with 2" brass cap, stamped: Monument projects 12" above ground. Recovered OBT - Tamarack 6" S 22° E 27.5 links (27.0 links), scribed BT.

T37N R9E
W 1/16 S 1/2
R1PCO

Description of monument and accessories I established to perpetuate the original location of this corner. As monument was in good condition and securely in ground, it was left in place. NBT - Tamarack 8" S 5° E 38.8 links, scribed 1/16 BT. Corner sets 30 links south of Cross Country Road.

Dated at Rhineland, Wis., this 25th day of February, 1977.

Signature Phillip T. Hansen Title Registered Land Surveyor Registration No. S-498
(County Surveyor, Registered Land Surveyor, or other duly authorized official)

Office of Register of Deeds, County of Oneida. I hereby certify that the within instrument was filed in this office for record on the 23rd day of March, 1977 at 3:00 o'clock P. M.

Dorcas V. Hagen
(Register of Deeds)

By: _____ Deputy

3709020030