

CERTIFIED LAND CORNER RESTORATION

Index No. **C-20**

State of Wisconsin

County of Oneida } ss.


I, Phillip T. Hansen, do hereby certify that on the 9th day of December 19 76, I found evidence of the EC 1/16 corner of Section 2 Township 37 North, Range 9 East, Fourth Principal Meridian,

as described hereon; and that from this evidence I established a new monument and accessories as described hereon to perpetuate the original location of this corner.


Resident witnesses:

Jim Claffin

Herb Wagoner

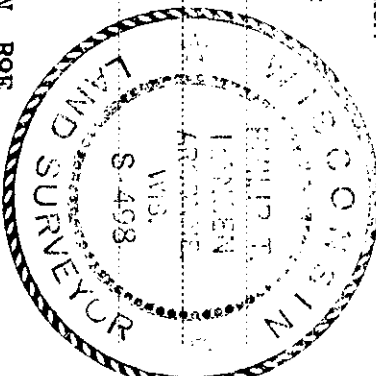

T37N R9E

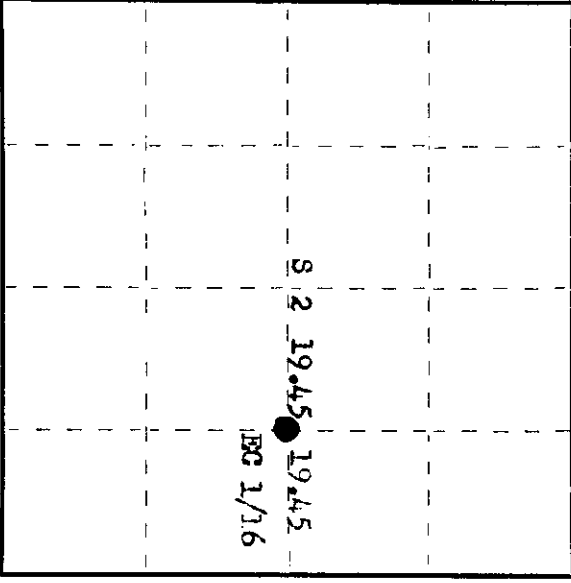

History of original corner establishment:

Corner established by N. Loftus and crew, Ripco Surveyors, in 1956. Ran random line N85°E from W 1/4 a distance of 77.87 chains to close out 10 1/2 links north of E 1/4. Ran the N-S 1/4 line from S 1/4 corner to N 1/4 corner, closed out 38 links west. Corrected line S & set 1/2 Cor. at 39.45 chains N 3° 13' W of S 1/4 and 38.97 chains east of W 1/4 corner. Set EC 1/16 at 58.42 equidistant between C 1/4 corner & E 1/4 corner. Old BT stump south of corner. Set iron pipe with brass cap.

Description of corner evidence found:

Recovered 1" iron pipe with 2" square brass cap in good condition and securely in ground. Cap stamped: Monument projects 12" above ground. No evidence of any BTs recovered.

T37N R9E
E 1/16
C ——— C
RIPCO

Description of monument and accessories I established to perpetuate the original location of this corner.

As monument was recovered in good condition, it was left in place. Marked NBTFs - Red Pine 6" S 41° W 21.0 links, scribed 1/16 BT. Red Pine 5" S 43° E 29.6 links, scribed 1/16 BT.

Dated at Rhinelander, Wis. this 25th day of February, 1977

Signature: _____ Title Registered Land Surveyor Registration No. S-498
(County Surveyor, Registered Land Surveyor, or other duly authorized official)

Office of Register of Deeds, County of Oneida
Instrument was filed in this office for record on the 23rd day of March, 1977
at 3:00 o'clock P. M.

Dorcas Savage Kuehn
(Register of Deeds)

By: _____ Deputy

3709022010