



CERTIFIED LAND CORNER RESTORATION

Index No. E-16

State of Wisconsin }  
County of Oneida } ss.

I Phillip T. Hansen do hereby certify that on the 18th day of September, 1978, I found evidence of the E 1/16 corner of Sections 3 and 10 Township 37 North, Range 9 East, Fourth Principal Meridian, as described hereon; and that from this evidence I established a new monument and accessories as described hereon to perpetuate the original location of this corner.

Resident witnesses:  
Jim Clafflin  
Herb Wagoner  
John Masbaum

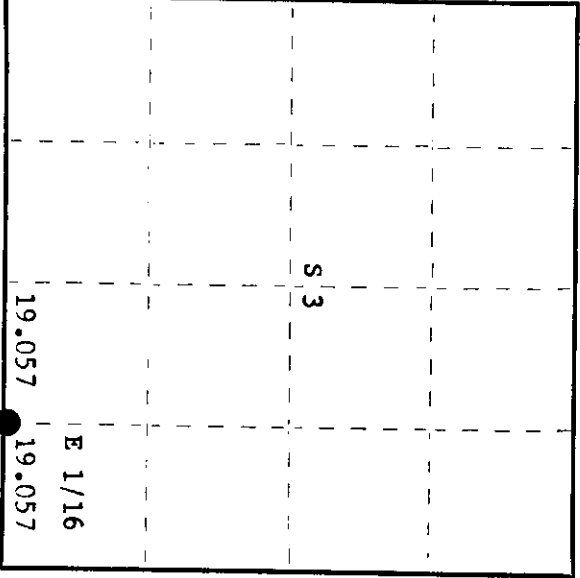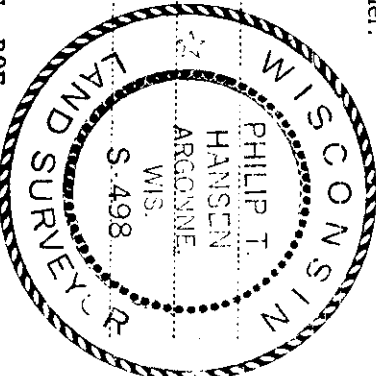

○ = Corner monument restored.

History of original corner establishment:

Corner established by N. Loftus, Ripco surveyor, in 1958. Ran random line east from Section Corner 3, 4, 9 and 10, bearing 86° 40' mag. and at 76.235 chains fell 3 links south of Section Corner 2, 3, 10 and 11. Set S 1/4 corner at 38.11 1/2 chains intermediate and set E 1/16 corner at 57.17 1/2 chains. Drove 3/4" x 12" iron rod in road bed and set reference monument 25 links north.  
Marked NBT's - Tamarack 7" S41°W, 76 1/2 links  
Tamarack 4" N5°E, 37-3/4 links  
Corrected bearing of line N86° 38' 30" E.

Description of corner evidence found:

Recovered Ripco's 1" iron pipe below the surface of road. The witness corner 25 links north has been completely mutilated.  
Recovered OBT - Tamarack 7" stump remains, S41°W, 76.5 links  
No evidence of tamarack 4" BT.  
Someone has run a survey line north from a point 1.35' west of Ripco's true corner.

Description of monument and accessories I established to perpetuate the original location of this corner.

Set a 1" iron pipe with 2" brass cap for witness corner 65.0 links north of the true corner. Monument projects 1' above ground - cap stamped:  
Marked NBT's to true corner -  
Black Spruce 7" S33°W, 71.5 links  
Black Spruce 5" N24°W, 63.3 links  
both scribed 1/16 BT  
T37N R9E  
S 3  
E 1/16  
S 10  
W.C.  
S 65 lks.

Dated at Rhineland, Wis., this 4th day of October, 1978

Signature Phillip T. Hansen Title Registered Land Surveyor Registration No. S-498  
(County Surveyor, Registered Land Surveyor, or other duly authorized official)

Office of Register of Deeds, County of Oneida  
Instrument was filed in this office for record on the 18th day of October, 1978  
at 1:50 o'clock P. M. I hereby certify that the within

By: Dennis George Fischer (Register of Deeds)

Deputy

3709030010