

CERTIFIED LAND CORNER RESTORATION


Index No. **E-14**

State of Wisconsin }  
 County of Oneida } ss.

I Phillip T. Hansen, do hereby  
 certify that on the 26th day  
 of April, 1976, I found  
 evidence of the W 1/16  
 corner of Section 3 and 10  
Township 37, North, Range  
9 East, Fourth Principal Meridian,  
 as described hereon; and that from this evidence  
 I established a new monument and accessories  
 as described hereon to perpetuate the original  
 location of this corner.

Resident witnesses:

Glen Barker  
Jim Claflin  
Herb Wagoner

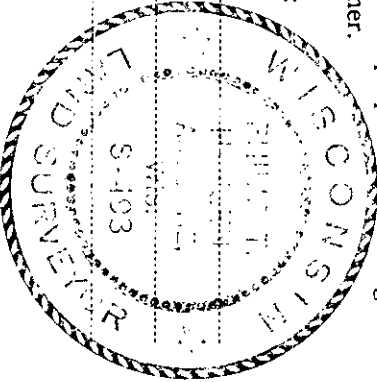

History of original corner establishment: This corner established by Ripco surveyor, Loftus, in 1958. From Section Corner 3, 4, 9, 10 ran random line east, bearing 86° 40' mag. 76.235 chains to point 3 lks south of sec. Corner. Set " 1/16 corner at 19.0575 chains east. Drove 3/4" x 12" rod in road for corner and set reference corner 25 lks north.  
 NBTs - Red Pine 2" N 32° W 31 1/2 lks.  
 Red pine 2" N 56° E 49 1/4 lks.


Description of corner evidence found:

Recovered 3/4" iron pipe inside a 1 1/2" iron pipe buried 8" below surface of road.  
 Recovered 1 1/2" OD iron pipe with 2" brass cap for reference corner, stamped.  
 Monument projects 12" above ground.  
 also an old 3" squared red pine stake scribed Cor. 25 lks so. laying beside it.  
 Recovered OBT - Red Pine 2" (8") N 32° " 31.5 lks. RIPCO  
N 1/16  
S 3  
S 10  
 Red Pine 2" N 56° E 49.25 lks (now a cut off stump). Cor. 25 lks so.

Description of monument and accessories I established to perpetuate the original location of this corner.

as corner and reference monument were in good condition, they were left in place.

NBT - Red Pine 6" N 55° W 59.7 lks, scribed 1/16 BT.

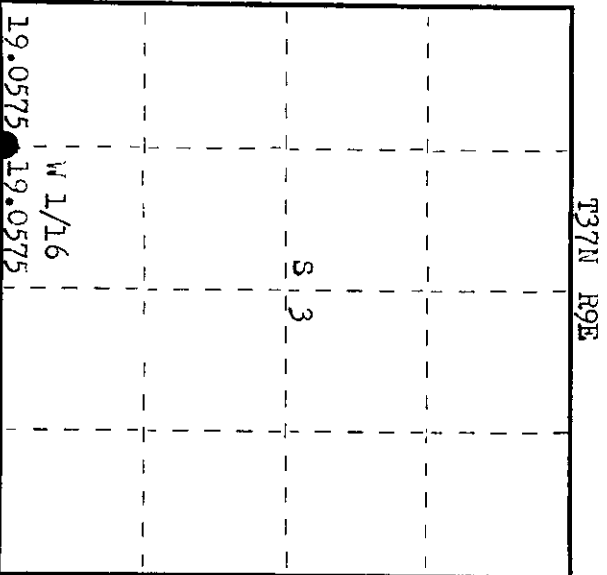

○ = Corner monument restored.

Dated at Rhineland, Wis, this 16th day of August, 1976  
 Signature Phillip T. Hansen Title Registered Land Surveyor Registration No. 5-498  
 County Surveyor, Registered Land Surveyor, or other duly authorized official

Office of Register of Deeds, County of Oneida  
 instrument was filed in this office for record on the 27th day of September, 1976  
 at 10 o'clock P. M.

Marie Leverage Kuehn  
 (Register of Deeds)

By \_\_\_\_\_ Deputy

3709030030