

CERTIFIED LAND CORNER RESTORATION

Index No. **D-16**

3709031010

History of original corner establishment:

Corner established by W. Loftis, 1850 survey, in 1953. From established 1/10, south line 100 554° 20' W. 39.10 links to close out 83 links east of 1/16 corner. Set on 1/16 corner at 10.50 chains, 41 links east. Set iron pipe and marked 1/16 - black spruce 4" x 4" x 38 links and black spruce 3" x 4" x 19 links.

Description of corner evidence found:

Recovered 1" iron pipe with 2" square brass cap, in good condition. Diameter 1.0000 in. Recovered black spruce 4" x 4" x 38 links, scribbled on 1/16 of (head). Black spruce 4" x 4" x 19 links, scribbled on 1/16 of (head). on 1/16 + 53

Description of monument and accessories I established to perpetuate the original location of this corner.

As the monument was recovered in poor condition, and found in place, it was left in place. Added standing 1976 4" x 4" brass cap. Monument projects 20" above ground. 1/16 - black spruce 3" x 4" x 100 links, scribbled 1/16 of. 1/16 - black spruce 4" x 4" x 44.3 links, scribbled 1/16 of.

State of Wisconsin


I, William W. Hansen, do hereby certify that on the 22nd day of September, 1976, I found evidence of the SE 1/4 corner of section 3



Township 37, North, Range 9 East, Fourth Principal Meridian,

as described hereon; and that from this evidence I established a new monument and accessories as described hereon to perpetuate the original location of this corner.

Resident witnesses:

Jim Clafflin

Norm Johnson

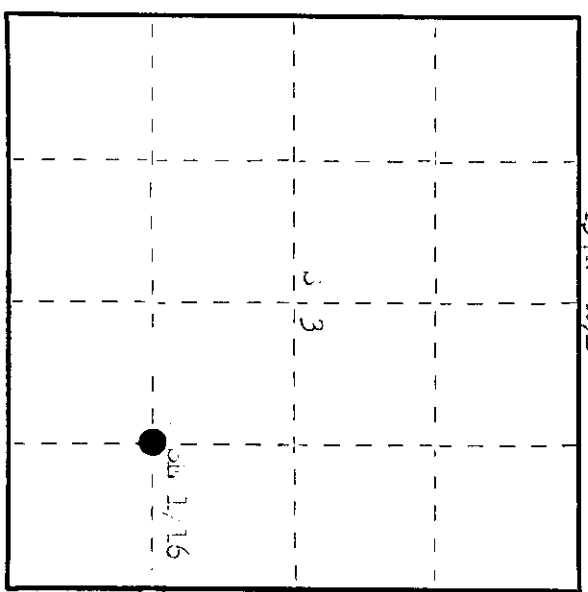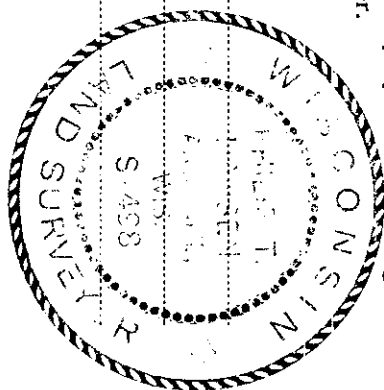

○ = Corner monument restored.

Dated at Wausau, Wis., this 4th day of November, 1976

Signature Julius P. Johnson Title Registered Land Surveyor OR County Surveyor, Registered Land Surveyor, or other duly authorized official) Registration No. 2493


James Vernon Kuehn
(Register of Deeds)

By: _____ Deputy