CERTIFIED LAND CORNER RESTORATION

Index No. C-16

3709032010

State of Wisconsin
County of Oneida } ss.

I Philip T. Hansen, do hereby certify that on the 22nd day of September, 1976, I found evidence of the C 1/16 corner of Section 3 Township 37, North, Range 9 East, Fourth Principal Meridian, as described hereon; and that from this evidence I established a new monument and accessories as described hereon to perpetuate the original location of this corner.

Resident witnesses:

Jim Sleflin

Herb Wagoner

WISCONSIN 3-1-83 LAND SURVEYOR

T37N R9E

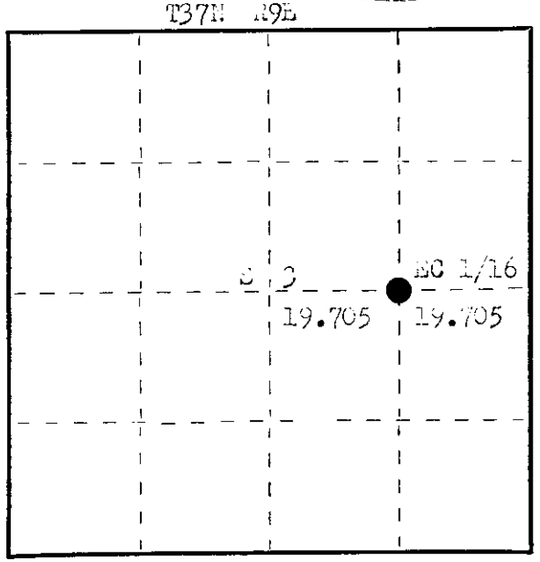

○ = Corner monument restored.

History of original corner establishment:

Corner established by .. Loftus, Wipco Surveyor, in 1953.
From established .. 1/4 corner, run radial line 208° 33 min. 18.14 chains, closing set 29 links south of .. 1/4 corner. Set .. C 1/16 corner at 19.705, 7. links north equidistant, between C 1/4 corner. Set iron pipe and marked ..ts - white pine 4" .. 43° .. 43-3/4 links, Tamarack 58° .. 4.5 links.

Description of corner evidence found:

Recovered 3/4" iron pipe with 2" .. 2" square brass cap in good condition.

Recovered Tamarack 4" .. 58° .. (.. 52° ..) 4.5 links (44.5 links) scribed .. 1/16 .. ST.
White pine 8" (10") .. 43° .. 43.5 links - scribing not visible.

Brass cap stamped:

C 1/16
C — C
S3
T37N

Monument projects 20" above ground.

Description of monument and accessories I established to perpetuate the original location of this corner.

As monument was in good condition, it was left in place. Added T37N R9E stamping to cap.

BTs - Red pine 8" .. 52° .. 27.9 links scribed 1/16 ST.

Dated at Rhinelander, Wis., this 3rd day of November, 1976.

Signature Philip T. Hansen Title Registered Land Surveyor Registration No. S-498
(County Surveyor, Registered Land Surveyor, or other duly authorized official)

Office of Register of Deeds, County of Oneida, I hereby certify that the within instrument was filed in this office for record on the 16th day of November, 1976 at 2:00 o'clock P. M.

Doris Veraye Kuehn
(Register of Deeds)

By ..... Deputy

FORM 985 H. C. MILLER CO., MILWAUKEE