

CERTIFIED LAND CORNER RESTORATION

Index No. **C-13-14**

State of Wisconsin


County of Oneida } ss.

I Phillip F. Jensen, do hereby certify that on the 27th day of September, 1976, I found evidence of the original corner of the Section 34, Range 27, North, Range 27, East, Fourth Principal Meridian, as described hereon; and that from this evidence I established a new monument and accessories as described hereon to perpetuate the original location of this corner.

Resident witnesses:

Jim Uhlman

Herb Agoner

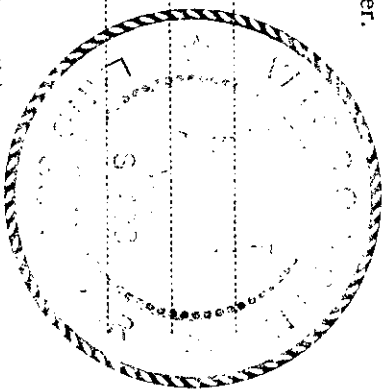

O = Corner monument restored.

History of original corner establishment: Original line between sec. 3 & 4, T4N R27E, Sec. 34, Oneida County, Wis., established by surveyor, in 1853. Set 1/4 corner at 40.40 links north, and west of 1/4 line in lake.



Description of corner evidence found:

Recovered 1/4 - 40.41 mag. 237.495 - 14.0 links, set back 1/4 - 23.0 links and 1.00 70 - 14.75 links, set back 1/4 - 23.0 links. also double 1/4 corner and iron line 23.00 for corner.

Description of monument and accessories I established to perpetuate the original location of this corner. Set a 2" iron pipe with brass cap from 1/4 corner and accessories. monument placed 1/4 above ground. In addition, I accessories established.

2470
1976 1974
1/4 24 23
O.R.-1976

Dated at Uhlenauer, Wis. this 27th day of September, 1976.

Signature Phillip F. Jensen, Title Registered Land Surveyor, OR Surveyor, (County Surveyor, Registered Land Surveyor, or other duly authorized official) Registration No. 498

Office of Register of Deeds, County of Oneida, I hereby certify that the within instrument was filed in this office for record on the 16th day of November, 1976 at 2:00 o'clock P. M.

Terrie Lehman Krecker
(Register of Deeds)

By _____ Deputy

3709032039