CERTIFIED LAND CORNER RESTORATION

Index No. B-15

370903302O

State of Wisconsin

County of Oneida } ss.

I Philip T. Hansen, do hereby certify that on the 23rd day of October, 1975, I found evidence of the S 1/16 corner of Section 3 Township 37, North, Range 9 East, Fourth Principal Meridian, as described hereon; and that from this evidence I established a new monument and accessories as described hereon to perpetuate the original location of this corner.

Resident witnesses:

Jim Claflin

Herb [illegible]

T37N R9E

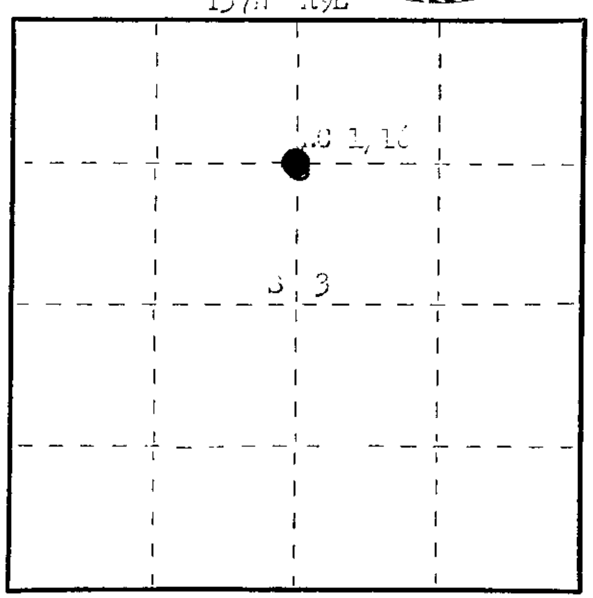

○ = Corner monument restored.

History of original corner establishment:

Corner established by [illegible] Loftus, [illegible] Surveyor, in 195[illegible]. [illegible] North 55° 30' [illegible] 79.[illegible] chains, closed out [illegible] East of [illegible] 1/4 corner. Established [illegible] 1/16 at 59.69 chains North 5° 55' [illegible] 71.[illegible] links East.
[illegible] - Tamarack 3" [illegible] 25° [illegible] links and Tamarack 3" [illegible] 5° [illegible] 75 links.

Description of corner evidence found:

Recovered 3/4" ID iron pipe with [illegible]" square brass cap projecting 12" above ground, [illegible]:

Recovered [illegible] - Tamarack 3" (4") [illegible]° [illegible] 75.5 links, scribing not [illegible]ible.
Tamarack 3" [illegible] 5° [illegible].0 links, now dead, scribed [illegible] 1/16 [illegible].

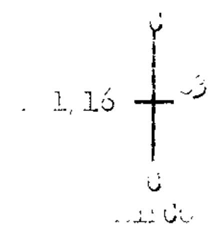

Description of monument and accessories I established to perpetuate the original location of this corner.

As the monument was recovered in good condition, it was left in place.
Added T37N R9E to [illegible] on cap.
[illegible] - [illegible] Spruce 4" [illegible] 68° [illegible] 66.6 links, scribed 1/16 [illegible].

Dated at Rhinelander, Wis., this 3rd day of November, 1975

Signature Philip T. Hansen Title Registered Land Surveyor Registration No. S-478
(County Surveyor, Registered Land Surveyor, or other duly authorized official)

Office of Register of Deeds, County of Oneida I hereby certify that the within instrument was filed in this office for record on the 2nd day of December, 1976 at 930 o'clock A. M.

Doris Verage Kuehn
(Register of Deeds)

By .... Deputy

FORM 985 H C MILLER CO., MILWAUKEE