

CERTIFIED LAND CORNER RESTORATION

Index No. C-D-13


State of Wisconsin }
County of Oneida } ss.

I, Phillip T. Hansen, do hereby certify that on the 21st day of September, 1976, I found evidence of the Leander Corner corner of South - Section 3 and 4 Township 37, North, Range 9 East, Fourth Principal Meridian, as described hereon; and that from this evidence I established a new monument and accessories as described hereon to perpetuate the original location of this corner.


Resident witnesses:

Jim Clarlin

Herb Wagoner

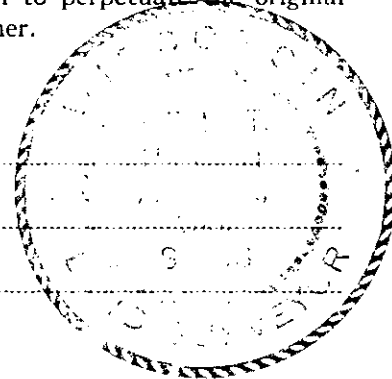

FORM 985 H. C. MILLER CO., MILWAUKEE

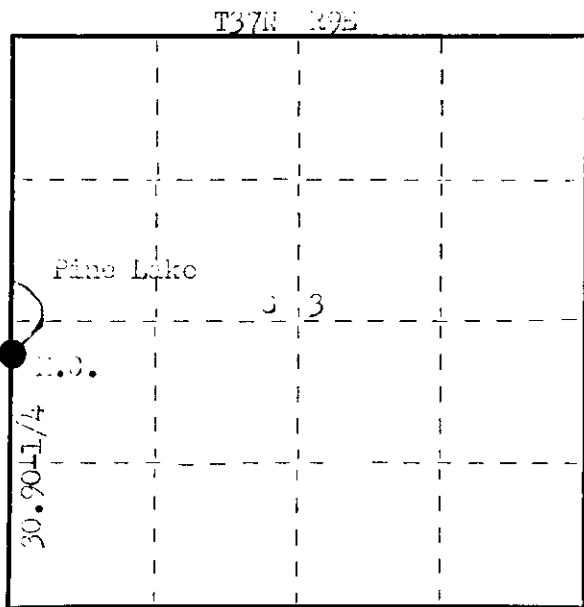

○ = Corner monument restored.

History of original corner establishment:

No mention of Leander Corner established by Wm. W. Southero, Deputy Surveyor, in 1893 when he ran this line.

Corner established by N. Loftus, Ripco Surveyor, in 1958. He ran a random line north from Section Corner 3, 4, 9 and 10, a distance of 77.875 chains, closing out 11 links west of Section Corner 33, 34, 3 and 4.

Set Leander Corner on south shore of Pine Lake at 30.904 chains.

Marked corner with 3/4" iron pipe with 2 1/2" brass plate, flush with ground.

Marked BT - White Pine 8" S 29° E 18-3/4 links.

Description of corner evidence found:

Recovered 3/4" iron pipe with 2" x 2" square brass plate attached:

The iron pipe was flush with ground.

Recovered white pine 8" S 29° E 10.75 links (10.4 links) scribed

N.O. 1/4 S.S. BT.

34 33
1/4
10.03-3/4 ch.
N.O.

Description of monument and accessories I established to perpetuate the original location of this corner.

As the monument was recovered in good condition, it was left as found.

Marked BTs - Red Pine 10" S 38° E 11.6 links, scribed N.O. BT.

Red Pine 8" S 4° E 9.7 links, scribed N.O. BT.

Dated at Rhineland, Wis., this 4th day of October, 1976.

Signature: Phillip T. Hansen Title: Registered Land Surveyor Registration No. 2-478

(County Surveyor, Registered Land Surveyor, or other duly authorized official)

Office of Register of Deeds, County of Oneida. I hereby certify that the within instrument was filed in this office for record on the 9th day of November, 1976 at 10:30 o'clock A M.

Doris Verage Kuehn
(Register of Deeds)

By _____ Deputy

3709047700