

U.S. PUBLIC LAND SURVEY MONUMENT RECORD


Note: This form is intended and designed to fulfill all requirements of Wisconsin Administrative Code, Chapter A-E 7.08 U.S. Public Land Survey Monument Record (3) (a) (b) (c) (d) (e) (f) (g) (h) (i). An additional sheet may be added if necessary to conform with said requirements.

(a) Corner location: Township 37 North

Range 9 East/West

Town/City/Village Pine Lake

County Oneida

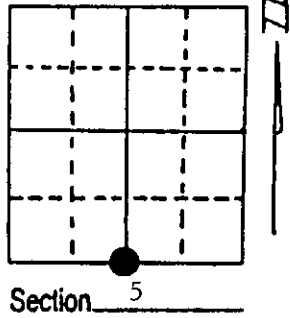

(b) (f) (g) (h) Description of monument found at this corner and if it was accepted, state all evidence (material, testimonial, occupational, plats, records, other monuments) used as a basis for accepting. If not accepted or if nothing was found, state evidence used as basis for establishing location. If reestablished through lost corner proportionate methods, indicate all monuments, distances and directions used to establish. Indicate type of monument found or set and sign post.

1863 - William Daugherty established this corner and set a wood post with BTs:
 8" Aspen, N24°W, 9 Links 12" Y. Pine, S18°E, 13 Links

1980 - BLM, Group #111, performed a Dependent Resurvey of Sections 5 and 6. This corner was found marked by an iron pipe, 1 1/2" x 2" high with local BTs:
 12" Norway Pine, S42°E, 39 Links 8" White Birch, N2°W, 45 Links


8/1/89 - Milo E. Stefan found the evidence that BLM used and restored corner by placement of an Oneida County Monument, 6" below road surface, making two new BTs and placing a sign post.

(c) (d) (e) Plan view of corner with ties to at least 4 witness monuments. If in disagreement with previously established corner, show the distances between the two corners and also indicate the ties to the disputed corner.

- 1) 2" x 30" aluminum county monument 6" below road surface/iron pipe along side
- 2) 10" Red Oak, N59°E, 81.20'
- 3) 6" Red Maple, S52°W, 39.57'
- *4) 12" Red Pine, S42°E, 25.73'
- *5) 8" White Birch, N2°W, 29.07'
- 6) Plastic sign post, South, 7.7'

*BTs by BLM

Distances to nail in side of BTs.
 BTs scribed "BT" in stump blaze.

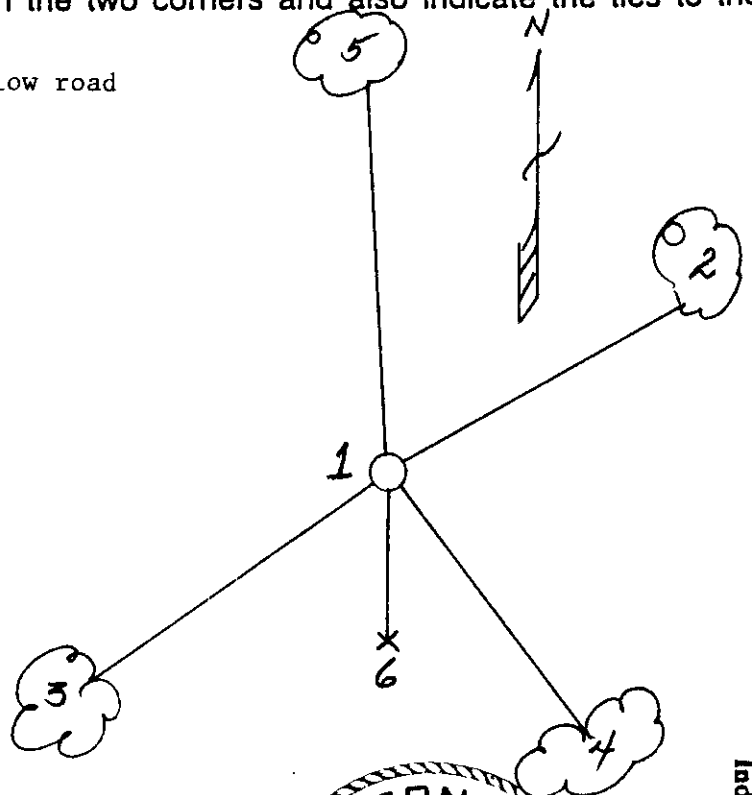

(i) I, Milo E. Stefan
 (type or print name) certify that the corner location on this record was determined by me or under my direction and control and that this U.S. Public Land Survey Monument Record is correct and complete to the best of my knowledge and belief.

Milo E. Stefan
 Signature

8/5/89

Date



Index No. E-7

3709050020