

CERTIFIED LAND CORNER RESTORATION

State of Wisconsin

County of Oneida

ss.

I James D. Rein do hereby certify that on the 10th day of October, 1979, I found evidence of the one-quarter corner of between sections 4 and 5 Township 37 North, Range 9 East, Fourth Principal Meridian, as described hereon; and that from this evidence I established a new monument and accessories as described hereon to perpetuate the original location of this corner:

Description of original monument and accessories and subsequent restorations:

wood post set by William W. Daugherty, Deputy Surveyor on September 1st, 1863, witnessed by a 15" white pine bearing S34°E, 38 lks (25.08 feet) and by a 10" Y. Pine bearing N29°W, 316 lks (208.56 feet)

Description of corner evidence found: recovered Point of rotted Cedar Post and 1/2" diameter iron rod with curved top found in swamp.

Description of monument and accessories I established to perpetuate the location of this corner:


replaced point of rotted Cedar Post with an Aluminum Oneida County Survey marker, witnessed by the following scribed bearing trees with P.A. nails set in lower blaze-

- 4" Tamarack N1°E, 46.74 feet
8" Tamarack S16°W, 59.97 feet
10" Norway Pine S62°E, 86.31 feet

Set scribed Tamarack Post to witness corner location

This is a copy of a copy. Originals apparently misplaced.

mqr 315191

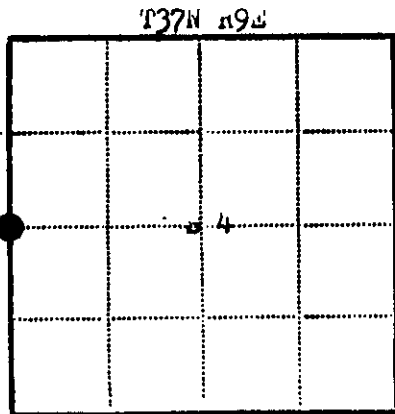

Legend: Circle = Corner monument restored, Square =

Resident witnesses none

Dated at Minocqua Wisconsin, this 13th day of November, 1979

Signature James D. Rein Title Registered Land Surveyor


Office of County of

I hereby certify that the within instrument was filed in this office for record on the day of 1979 and was filed in Book No. Page No. of County Records.

Signature Title

Township, Range, Section, Index No., Page No.