U.S. PUBLIC LAND SURVEY MONUMENT RECORD

Note: This form is intended and designed to fulfill all requirements of Wisconsin Administrative Code, Chapter A-E 7.08 U.S. Public Land Survey Monument Record (3) (a) (b) (c) (d) (e) (f) (g) (h) (i). An additional sheet may be added if necessary to conform with said requirements.

(a) Corner location: Township 37 North

Range 9 East/West

Town/~~City/Village~~ Pine Lake

County Oneida

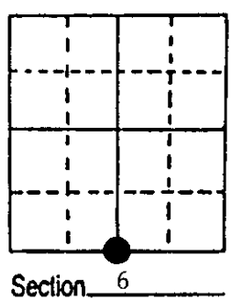

(b) (f) (g) (h) Description of monument found at this corner and if it was accepted, state all evidence (material, testimonial, occupational, plats, records, other monuments) used as a basis for accepting. If not accepted or if nothing was found, state evidence used as basis for establishing location. If reestablished through lost corner proportionate methods, indicate all monuments, distances and directions used to establish. Indicate type of monument found or set and sign post.

1863 - William Daugherty established this corner and set a wood post with BTs:
12" Y. Pine, N18°W, 4 Links 8" Y. Pine, S27°W, 16 Links

1980 - BLM, Group #111, performed a Dependent Resurvey of Sections 5 and 6. This Quarter Corner was found to be marked by a 1 1/2" x 12" iron pipe with a 4" x 4" x 36" scribed post along side.

8/1/89 - Milo E. Stefan found above evidence and restored corner by placement of an Oneida County Monument and sign post with new BTs.

(c) (d) (e) Plan view of corner with ties to at least 4 witness monuments. If in disagreement with previously established corner, show the distances between the two corners and also indicate the ties to the disputed corner.

1) 2" x 30" Aluminum County Monument
2) 10" Red Pine, N77°E, 21.22'
3) 10" Red Pine, S65°E, 24.66'
4) 14" Red Pine, S27°W, 11.73'
5) 11" Red Pine, N19°W, 17.49'
6) Plastic sign post, North, .9'

Distances to nail in side of BTs.
BTs scribed "BT" in stump blaze.

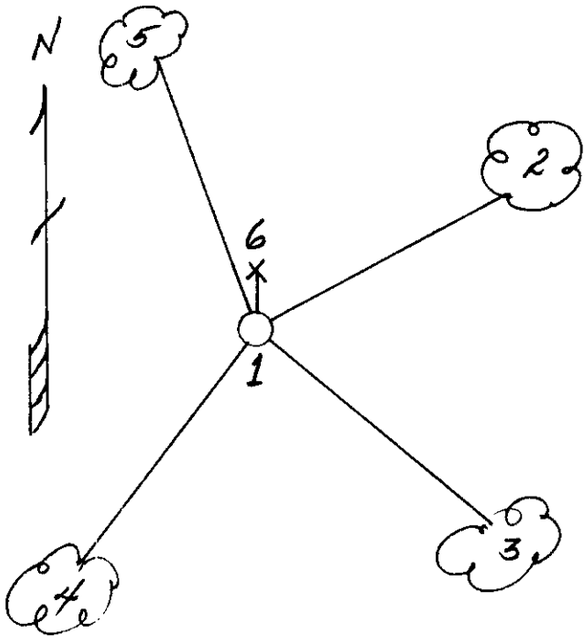

(i) I, Milo E. Stefan
(type or print name) certify that the corner location on this record was determined by me or under my direction and control and that this U.S. Public Land Survey Monument Record is correct and complete to the best of my knowledge and belief.

Mil E Stefan
Signature

8/5/89
Date

Index No. E-3

3709060020