U.S. PUBLIC LAND SURVEY MONUMENT RECORD

Note: This form is intended and designed to fulfill all requirements of Wisconsin Administrative Code, Chapter A-E 7.08 U.S Public Land Survey Monument Record (3) (a) (b) (c) (d) (e) (f) (g) (h) (i). An additional sheet may be added if necessary to conform with said requirements.

(a) Corner location: Township 37 North

Range 9 East/~~West~~

Town/~~City~~/~~Village~~ Pine Lake

County Oneida

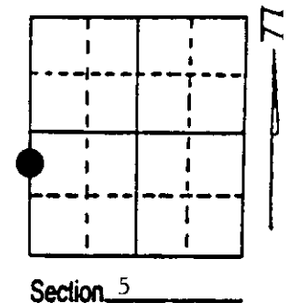

(b) (f) (g) (h) Description of monument found at this corner and if it was accepted, state all evidence (material, testimonial, occupational, plats, records, other monuments) used as a basis for accepting. If not accepted or if nothing was found, state evidence used as basis for establishing location. If reestablished through lost corner proportionate methods, indicate all monuments, distances and directions used to establish. Indicate type of monument found or set and sign post.

1863 - Wm. Daugherty established this Meander Corner on South Shore of lake. He set wood post for M.C. and two BTs:
10" Tamarack, S45°E, 7 Lks 6" Tamarack, S64°W, 8 Lks

1980 - BLM, under special instructions, restored this corner, set an aluminum monument with two BTs:
10" White Pine, N46°E, 65 Lks (42.9') 12" Red Pine, West, 96 Lks (63.36')

8/10/1992 - Milo E. Stefan found monument and Red Pine BT in good condition. The White Pine BT being recently cut down. We made three new BTs and set a Plastic Sign Post.

(c) (d) (e) Plan view of corner with ties to at least 4 witness monuments. If in disagreement with previously established corner, show the distances between the two corners and also indicate the ties to the disputed corner.

1) 2" x 30" Aluminum Monument
2) White Pine Stump, N46°E, 42.90'
3) 10" Red Maple, S36°E, 25.48'
4) 3" Red Oak, S47°W, 33.17'
5) 12" Red Pine, West, 63.36'
6) 10" Red Oak, N32°W, 17.21'
7) Plastic sign post, South, 0.6'

Distances to nail in side of BTs.
Stump blaze scribed "BT".

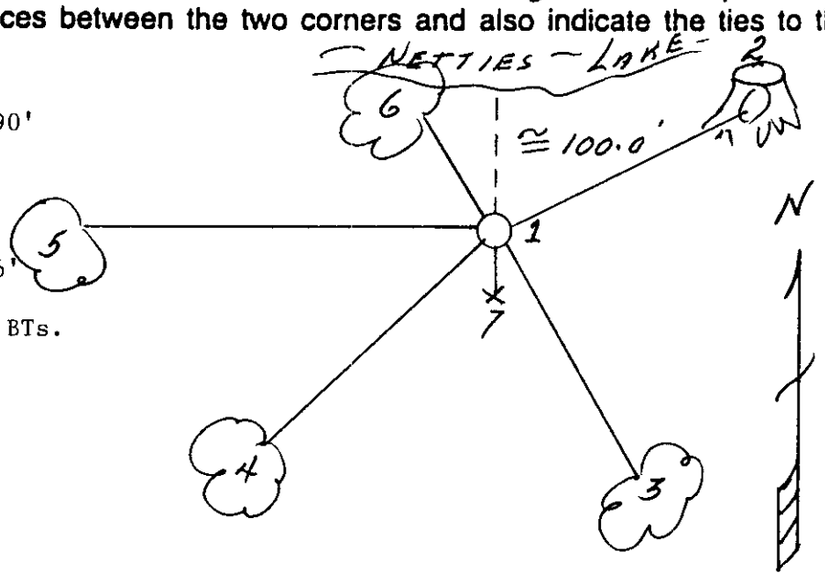

(i) I, Milo E. Stefan

(type or print name) certify that the corner location on this record was determined by me or under my direction and control and that this U.S. Public Land Survey Monument Record is correct and complete to the best of my knowledge and belief.

Milo E. Stefan — December 7, 1992

Signature **Date**

WISCONSIN
MILO E. STEFAN
S-1558
RHINELANDER, WIS.
LAND SURVEYOR

Index No. C,D-5

3709061600
Stamp