CERTIFIED LAND CORNER RESTORATION

Index No. C-3

3709062020

State of Wisconsin
County of Oneida } ss.

I Philip T. Hansen, do hereby certify that on the 9th day of May, 1977, I found evidence of the C 1/4 corner of Section 6 Township 37, North, Range 9 East, Fourth Principal Meridian, as described hereon; and that from this evidence I established a new monument and accessories as described hereon to perpetuate the original location of this corner.

Resident witnesses:

Jim Claflin

Herb Wagoner

WISCONSIN PHILIP T. HANSEN ARBONNE, WIS. S-498 LAND SURVEYOR

T37N R9E

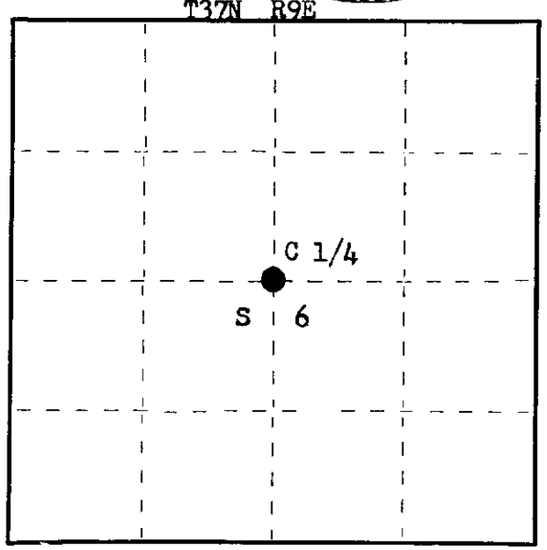

O = Corner monument restored.

History of original corner establishment:

Description of corner evidence found:

Recovered a 1-1/4" well point in center of Spider Lake Road. Well point is very old, approximately 10" below surface of road, directly in line with old N-S fence line which runs north.

Description of monument and accessories I established to perpetuate the original location of this corner.

Set a 2" iron pipe with brass cap, 75 links north of true corner for a witness corner. Monument projects 24" above ground. Cap stamped:
Marked NBTs - Red Pine 8" N 28° W, 78.0 links, scribed C 1/4 BT.
Red Pine 7" N 56° W, 114.6 links, scribed C 1/4 BT.

T37N R9E
C 1/4 S|6
S 75 lks to Cor.
S498-1977

Dated at Rhinelander, Wis., this 10th day of May, 1977.

Signature Philip T. Hansen. Title Registered Land Surveyor Registration No. S-498
(County Surveyor, Registered Land Surveyor, or other duly authorized official)

Office of Register of Deeds, County of Oneida, I hereby certify that the within instrument was filed in this office for record on the 11th day of May, 1977 at 10:30 o'clock A. M.

Irene Verage Kuehn
(Register of Deeds)

By ..... Deputy

FORM 985