CERTIFIED LAND CORNER RESTORATION

Index No. J-7

State of Wisconsin
County of Oneida } ss.

I Philip T. Hansen, do hereby certify that on the 27th day of August, 19 76, I found evidence of the quarter corner of section 5 and 17 Township 37, North, Range 9 East, Fourth Principal Meridian, as described hereon; and that from this evidence I established a new monument and accessories as described hereon to perpetuate the original location of this corner.

Resident witnesses:

Jim Claflin

Herb Rouer

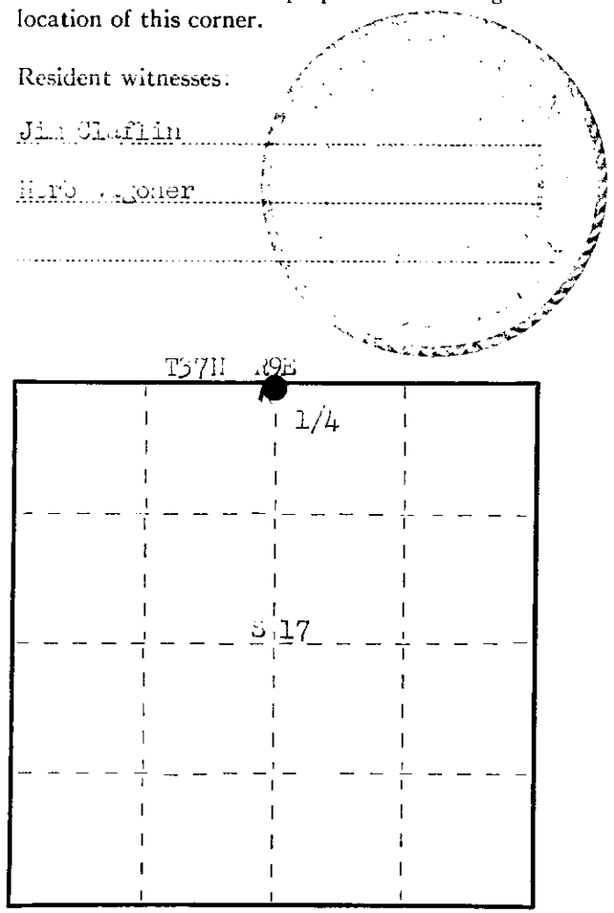

○ = Corner monument restored.

History of original corner establishment:

Original Corner established by [illegible] Dougherty, Deputy Surveyor, in 1856, from which Witness Tree 16" bears S 76° W 30 links and Yellow Pine 8" bears N 45° E 24 links. Corner restored by Drivas and Crew, Mapco Surveyors, in 1962. Ran random line east a distance of 43.880 chains to N 1/4 corner, marked corner with iron pipe and marked BTs - Pine 9" N 64° W .40 chains, Pine 3½" S 10° W .105 chains.

Description of corner evidence found:

Recovered 2" iron pipe, no brass cap.
Recovered BTs - Red Pine 12" N 64° W 40.0 links, scribed 1/4 S8 BT.
Red Pine 3½" (6") S 10° W 10.5 links, scribed 1/4 S17 BT.

Description of monument and accessories I established to perpetuate the original location of this corner.
Replaced old iron pipe with 2½" Bernitsen W-1 round monument stamped:
Monument proj ces 20" above ground.
BT - Red Pine 20" S 32° W 37.0 links, scribed 1/4 BT.
Monument and BTs painted blue.

T37N R9E
1/4 S 8
S 17
S498-1976

Dated at Rhinelander, Wis., this 29th day of September, 19 76

Signature Philip T. Hansen Title Registered Land Surveyor Registration No. S-498
(County Surveyor, Registered Land Surveyor, or other duly authorized official)

Office of Register of Deeds, County of Oneida, I hereby certify that the within instrument was filed in this office for record on the 9th day of November, 19 76 at 10:32 o'clock A M.

Doris Verage Kuehn
(Register of Deeds)

By ..... Deputy

FORM 985 H. C. MILLER CO., MILWAUKEE

370908002O