

CERTIFIED LAND CORNER RESTORATION

Index No. A-13

State of Wisconsin

County of Oneida

ss.

I Phillip T. Hansen, do hereby certify that on the 27th day of December, 1976, I found evidence of the S 1/16 corner of Section 9 & 10



Township 37, North, Range 9 East, Fourth Principal Meridian,

as described hereon; and that from this evidence I established a new monument and accessories as described hereon to perpetuate the original location of this corner.

Resident witnesses:

Jim Clarlin

Hert Wagoner

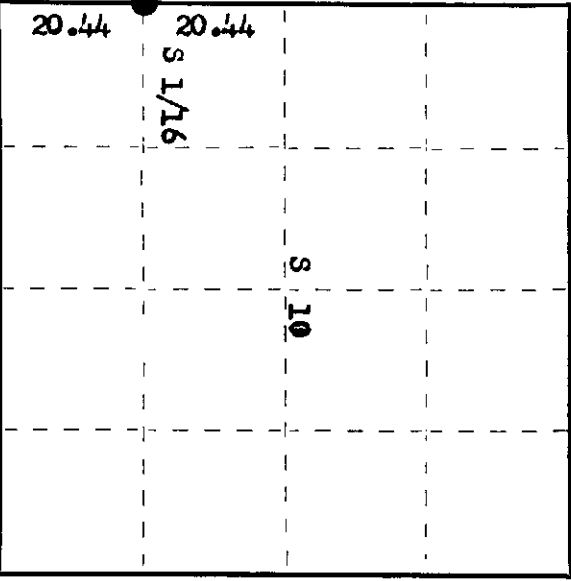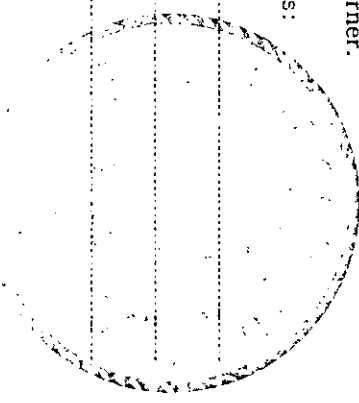

○ = Corner monument restored.

History of original corner establishment:

Corner established by N. Loftus, Ripco Surveyor, in 1958. He ran a Random Line 181° 50' mag. from Section Corner 3, 4, 9 and 10, 81.52 chains to close out 29 1/2 links west of Section Corner. Set S 1/16 corner at 61.07-3/4 chains 22 links east. Marked BFs - Black Spruce 4" N 10° W 27 1/2 links and Black Spruce 5" S 49° W 6 links.

Description of corner evidence found:

Recovered 1" iron pipe with 2" square brass cap in good condition and securely in ground. Recovered Black Spruce 4" (6") N 10° W 27.5 links, scribed 1/16 S9 BF. Black Spruce 5" (6") S 49° W 6.0 links, (6.5 links) scribing not visible.

Description of monument and accessories I established to perpetuate the original location of this corner.

As monument was found in good condition, it was left in place. Monument projects 20" above ground. Cap stamped: Corner sets 6.5 chains south of Pine Creek firelane.

T37N R9E  
S 1/16 S 1/2  
RIPCO

Dated at Rhineland, Wis., this 17th day of January, 1977

Signature: Phillip T. Hansen Title Registered Land Surveyor Registration No. S-498  
(County Surveyor, Registered Land Surveyor, or other duly authorized official)

Office of Register of Deeds, County of Oneida. I hereby certify that the within instrument was filed in this office for record on the 10th day of February, 1977 at 10 o'clock AM.

James George Tuckner  
(Register of Deeds)

By Joseph M. Bremer Deputy

3709091000