

CERTIFIED LAND CORNER RESTORATION

Index No. **J-16**

State of Wisconsin }  
County of Oneida } ss.



I Phillip T. Hansen, do hereby certify that on the 6th day of January, 1977, I found evidence of the E 1/16 corner of Section 10 & 15 Township 37, North, Range 9 East, Fourth Principal Meridian,

as described hereon; and that from this evidence I established a new monument and accessories as described hereon to perpetuate the original location of this corner.

Resident witnesses:

Jim Clafflin

Herb Wagoner

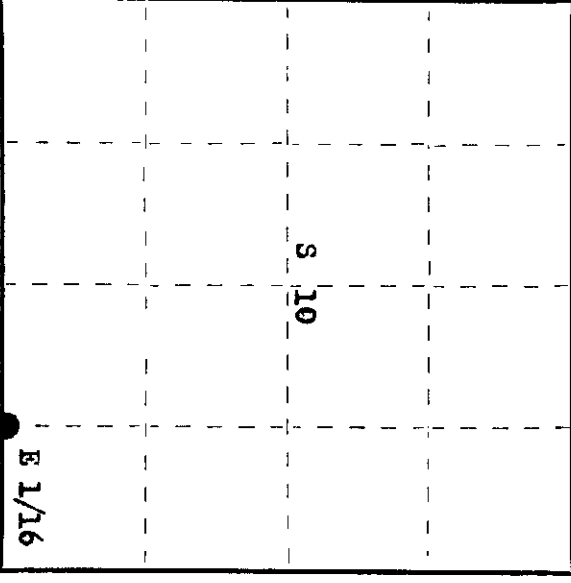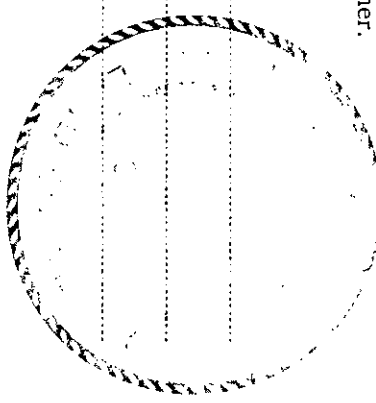

○ = Corner monument restored.

History of original corner establishment:

Corner established from Section Corner 10, 11, 14, 15. Ran random line west to an old blazed line, located E 1/16 in old fence corner. Fence runs west, declination 5° East. Set iron pipe and marked 10" Birch in fence line.

Description of corner evidence found:

Recovered 1" iron pipe with 2" square brass cap, stamped: **T37N R9E S 10 S 15**  
Monument projects 20" above ground. **E 1/16**  
Recovered OBTS - White Birch 10" N 7° E 16.3 links, scribing not legible. **RIPCO**  
Maple 6" S50° W 30.0 links, scribed 1/16 S15 BT.

Description of monument and accessories I established to perpetuate the original location of this corner. **As monument was in good condition and firmly in ground, it was left as found. No additional accessories established.**

Dated at Rhinelander, Wis., this 18th day of January, 19 77

Signature Phillip Hansen Title Registered Land Surveyor Registration No. S-498  
(County Surveyor, Registered Land Surveyor, or other duly authorized official)

Office of Register of Deeds, County of Oneida. I hereby certify that the within instrument was filed in this office for record on the 24th day of February, 19 77 at 100 o'clock P. M.

By Debra Terage Kuehn Deputy  
(Register of Deeds)

3709100010