

CERTIFIED LAND CORNER RESTORATION

Index No. J-21

State of Wisconsin

County of Oneida

} ss.



I Phillip T. Hansen, do hereby certify that on the 4th day of February, 19 77, I found evidence of the Section corner of 11, 12, 13, 14 Township 9 North, Range 37 Fourth Principal Meridian,

as described hereon; and that from this evidence I established a new monument and accessories as described hereon to perpetuate the original location of this corner.

Resident witnesses:

Jim Clarlin

Herb Wagoner

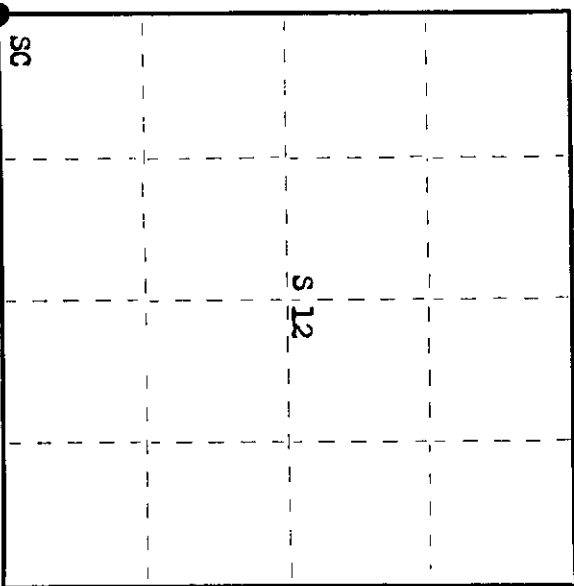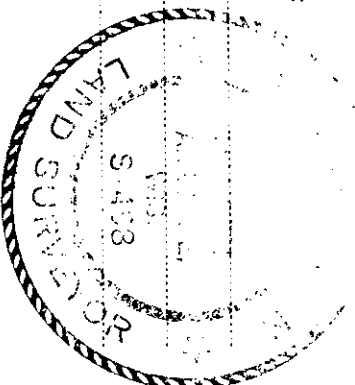

○ = Corner monument restored.

History of original corner establishment:

Original Corner established by Wm. E. Dougherty, Deputy Surveyor, in 1863, from which Yellow Pine 10" bears N 10° E 14 links and Yellow Pine 8" bears N 89° W 34 links.

Corner recovered by D.H. Vaughan, County Surveyor, in 1897. Ran the line between Section 11 and 12 from recovered corner, SW Corner Section 12.

Corner recovered by M. Smith, Ripco Surveyor, in 1950. Set 2" iron pipe, no mention of BTs marked.

Description of corner evidence found:

Recovered 2" iron pipe with 4" square brass cap. Monument was leaning and poorly set. Cap stamped: Monument projects 30" above ground. No evidence of any BTs.

T37N R9E  
S 11 | 12  
14 | 13  
RIPCO

Description of monument and accessories I established to perpetuate the original location of this corner.

Reset monument in its old hole. Monument now projects 30" above ground.

NBTs - Red Pine 10" S 34° E 17.5 links, scribed SC-BT.

Black Spruce 10" N 65° W 80.2 links, scribed SC-BT.

Red Pine 14" N 5° E 95.0 links, scribed SC.

Dated at Rhinelander, Wis., this 16th day of March, 19 77.

Signature Phillip T. Hansen Title Registered Land Surveyor Registration No. S-498  
(County Surveyor, Registered Land Surveyor, or other duly authorized official)

Office of Register of Deeds, County of Oneida  
Instrument was filed in this office for record on the 23rd day of March, 19 77  
at 3:05 o'clock P. M.

Verne Wenzel Kuehn  
(Register of Deeds)

By: \_\_\_\_\_ Deputy

3709110000