

State of Wisconsin

County of Oneida

ss.

I Phillip T. Hansen, do hereby certify that on the 9th day of February, 1977, I found evidence of the E 1/16 corner of Section 11 & 14



Township 37, North, Range 9 East, Fourth Principal Meridian,

as described hereon; and that from this evidence I established a new monument and accessories as described hereon to perpetuate the original location of this corner.

Resident witnesses:

Jim Claflin

Herb Wagoner

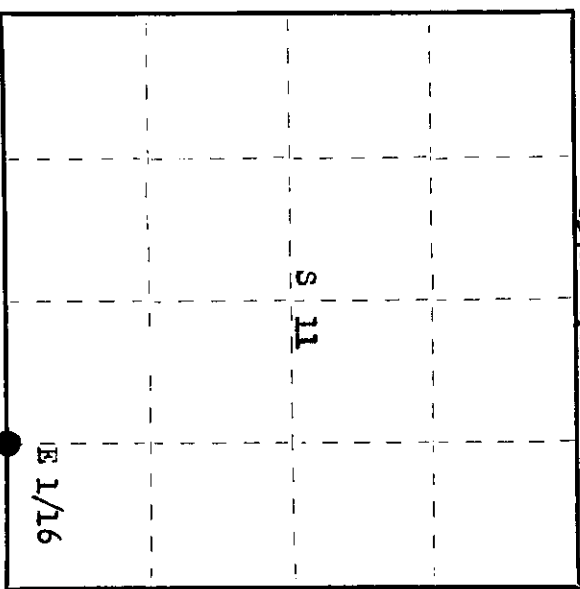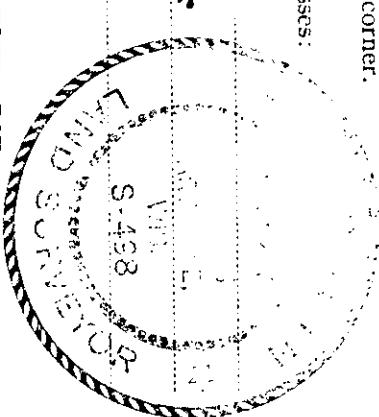

○ = Corner monument restored.

3709110010

History of original corner establishment:

Corner established by Drivas and crew, Ripco Surveyors, in 1962. From recovered Section Corner 11, 12, 13, 14, ran traverse 91° 49' 35" bearing S 87° 33' 44" to S 1/4 corner. Computed distance 38.805 chains at corrected bearing S 87° 45' 30" W. Set E 1/16 corner at 19.902 chains equidistant. No record of any BFs established.

Description of corner evidence found:

Recovered 1" iron pipe with 2" square brass cap in good condition and securely in ground.

Cap stamped:

Monument projects 20" above ground.

OBFs - Black Spruce 7" N 64° E 31.0 links, scribed E 1/16 S11 BF.

Black Spruce 8" S 42° E 62.0 links, scribed E 1/16 S14 BF.

Distances measured to center of BFs.

T37N R9E
S 11
E 1/16
S 14
RIPCO

Description of monument and accessories I established to perpetuate the original location of this corner.

As monument was recovered in good condition and securely in ground, it was left as recovered. Added stamping T37N R9E to brass cap. No additional accessories established.

Dated at Rhineland, Wis., this 16th day of March, 1977.

Signature Phillip T. Hansen Title Registered Land Surveyor Registration No. S-498
(County Surveyor, Registered Land Surveyor, or other duly authorized official)

Office of Register of Deeds, County of Oneida, I hereby certify that the within instrument was filed in this office for record on the 23rd day of March, 1977 at 3:00 o'clock P. M.

Dorice Heritage Kuehn
(Register of Deeds)

By: _____ Deputy