

CERTIFIED LAND CORNER RESTORATION

Index No. J-19

State of Wisconsin

County of Oneida

ss.

I Phillip T. Hansen

certify that on the 9th day of February, 1977, I found

evidence of the Quarter corner of Section 11 & 14


Township 37, North, Range 9 East, Fourth Principal Meridian,

as described hereon; and that from this evidence I established a new monument and accessories as described hereon to perpetuate the original location of this corner.

Resident witnesses:

Jim Claflin

Herb Wagoner

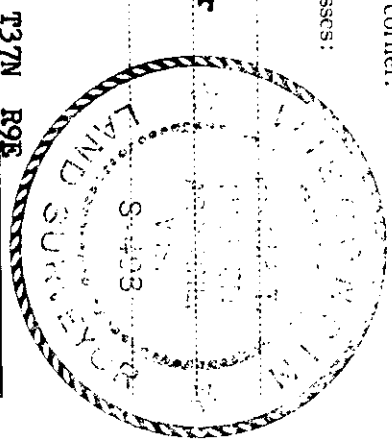

History of original corner establishment:  
Original Corner established by Wm. E. Dougherty, Deputy Surveyor, in 1863, from which Yellow Pine 8" bears S 43° E 62 links and Yellow Pine 10" bears N 13° E 45 links. Corner recovered by Drivas and crew, Ripco Surveyors, in 1962. Ran traverse west from Section Corner 11, 12, 13 and 14 to 1/4 corner. Computed distance 38.805 chains, corrected bearing S 87° 45' 30" W.  
Set iron pipe with brass cap. No mention of any BTs established.

Description of corner evidence found:

Recovered 1 1/2" iron pipe with 4" square brass cap in good condition and securely in ground.


Recovered OBTs - Black Spruce 6" N 50° W 32.5 links, scribing not legible.

Black Spruce 6" S 8° E 25.0 links, scribed 1/4 BT.

Description of monument and accessories I established to perpetuate the original location of this corner.  
As monument was recovered in good condition, it was left as recovered.

Monument projects 24" above ground. Cap is stamped:  
NBT - Black Spruce 6" S 86° E 22.6 links, scribed 1/4 BT.

T37N R9E  
1/4 S S 11  
1/4

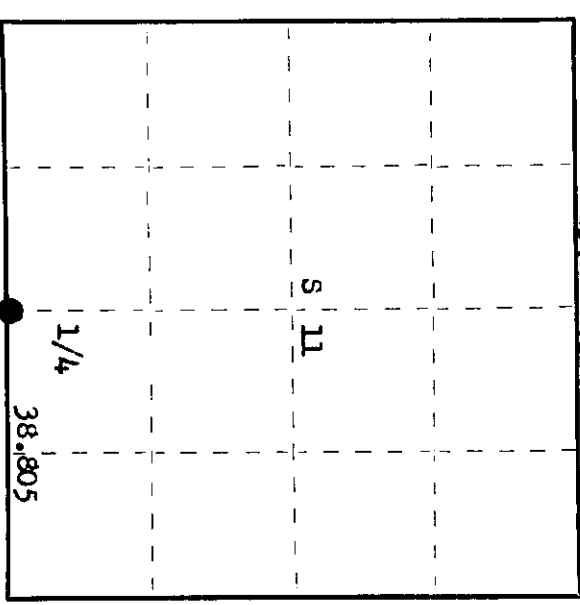

○ = Corner monument restored.

Dated at Rhineland, Wis., this 16th day of March, 1977.

Signature Phillip T. Hansen Title Registered Land Surveyor Registration No. S-498  
(County Surveyor, Registered Land Surveyor, or other duly authorized official)

Office of Register of Deeds, County of Oneida  
Instrument was filed in this office for record on the 23rd day of March, 1977  
at 3:00 o'clock P. M.

Dennis Teranga Kuehn  
(Register of Deeds)

By: \_\_\_\_\_ Deputy