CERTIFIED LAND CORNER RESTORATION

Index No. H-21

3709 11 10 00

State of Wisconsin
County of Oneida } ss.

I Philip T. Hansen, do hereby certify that on the 10th day of September, 19 77, I found evidence of the S 1/16 corner of Section 11 & 12 Township 37, North, Range 9 East, Fourth Principal Meridian, as described hereon; and that from this evidence I established a new monument and accessories as described hereon to perpetuate the original location of this corner.

Resident witnesses:

Jim Claflin

Herb Wagoner

WISCONSIN PHILIP T. HANSEN WIS. S-498 LAND SURVEYOR

T37N R9E

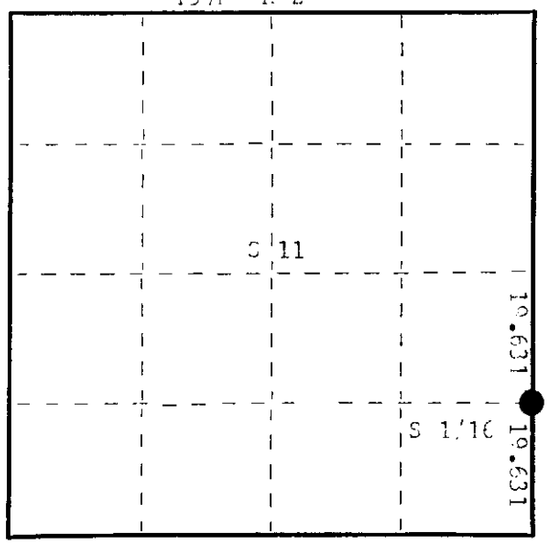

○ = Corner monument restored.

History of original corner establishment:
Corner established by Drivas and crew, Pipco Surveyors, in 1962. Ran random line S 1° 07' 40" W from NE corner, 79.524 chains to close out .13200 chains west of SE corner.

Set S 1/16 corner at 39.893 chains intermediate between E 1/4 corner and SE corner.
Marked WPTs - Black Spruce 4" S79°W, 21 links
Black Spruce 5" N42°E, 33 links

Description of corner evidence found:
Recovered 3/4" iron pipe with alloy cap, not stamped. Monument found in excellent condition.
Recovered CBTs - Black Spruce 5" N42°E, 33.5 links (32.6 links) scribed 1/16 BT.
Black Spruce 4" (5") S79°W, 31.0 links (31.3 links), scribed 1/16 BT.

Description of monument and accessories I established to perpetuate the original location of this corner.
Stamped alloy cap:
Monument projects 12" above ground.
No additional accessories established.

T37N R9E
S 1/16 S11, S12
1977

Dated at Rhinelander, Wis., this 23rd day of September, 19 77

Signature Philip T. Hansen Title Registered Land Surveyor Registration No. S-498
(County Surveyor, Registered Land Surveyor, or other duly authorized official)

Office of Register of Deeds, County of Oneida I hereby certify that the within instrument was filed in this office for record on the 12th day of October, 19 77 at 9:15 o'clock A. M.

Doris Verage Kuehn
(Register of Deeds)

By ..... Deputy

FORM 985 H C MILLER CO., MILWAUKEE