

CERTIFIED LAND CORNER RESTORATION

Index No. **F-20**

State of Wisconsin



County of Oneida } ss.

I, Philip T. Hansen, do hereby certify that on the 10th day of September, 1977, I found evidence of the NE 1/16 corner of Section 11 Township 37, North, Range 9 East, Fourth Principal Meridian, as described hereon; and that from this evidence I established a new monument and accessories as described hereon to perpetuate the original location of this corner.

Resident witnesses:

Jim Claffin

Herl Jaegerer

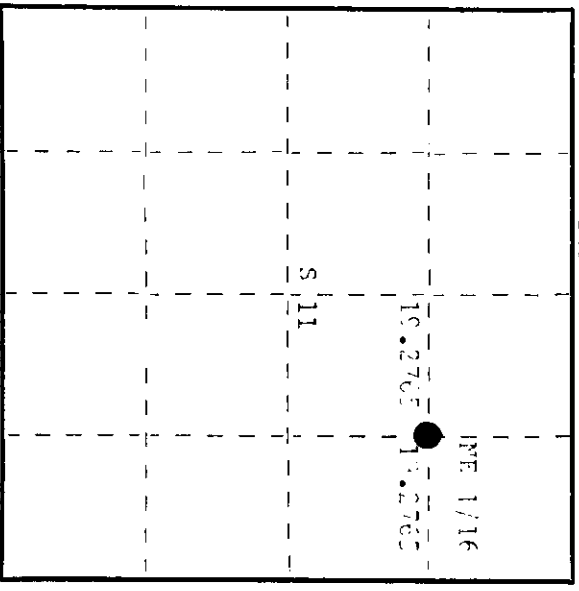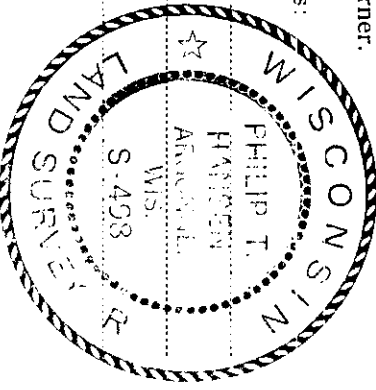

History of original corner establishment:

Corner established by Drivas and crew, Ripco surveyors, in 1962. Ran random line east from NW 1/16 to W 1/16 east line at 36.553 chains closed out 4617 chains south. Set NE 1/16 at 19.2765 chains intermediate. Set iron pipe and marked MPTs - Norway Pine 5" dia E, 331 links. White line 7" dia, 73 links.

Description of corner evidence found:

Recovered 2 1/2" iron pipe with 2" alloy cap, stamped: Monument projects 28" above ground. Recovered (RTS - Red line 7" dia E, 331 links, 33.5 links, marked NE 1/16 BT, NE 1/16 + White line 7" dia, 73 links, set on NE 1/16 BT. Ripco

Description of monument and accessories I established to perpetuate the original location of this corner. As monument was recovered in good condition, it was left in place. No additional accessories recovered.

Dated at Phirelander, Wis., this 23rd day of September, 1977

Signature Philip T. Hansen Title Registered Land Surveyor Registration No. 5-400  
(County Surveyor, Registered Land Surveyor, or other duly authorized official)

Office of Register of Deeds, County of Oneida at 9:15 o'clock A. M. 12th day of October, 1977

Doris Verage Fuchs  
(Register of Deeds)

By Doris Verage Fuchs Deputy

3709113010