

CERTIFIED LAND CORNER RESTORATION

Index No. N-25

State of Wisconsin

County of Oneida

} ss.

I Phillip T. Hansen, do hereby certify that on the 21st day of February, 1977, I found evidence of the Section corner of 13 - 18 - 24 - 19



Township 37, North, Range 10 & 9 East, Fourth Principal Meridian,

as described hereon; and that from this evidence I established a new monument and accessories as described hereon to perpetuate the original location of this corner.

Resident witnesses:

Jim Claflin

Herb Wagoner

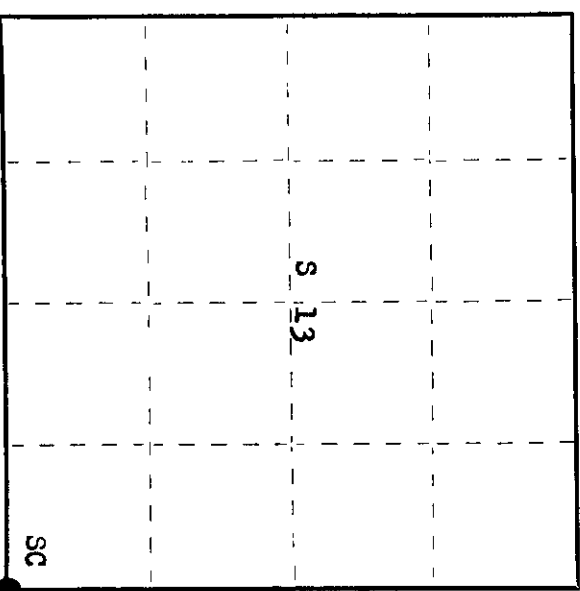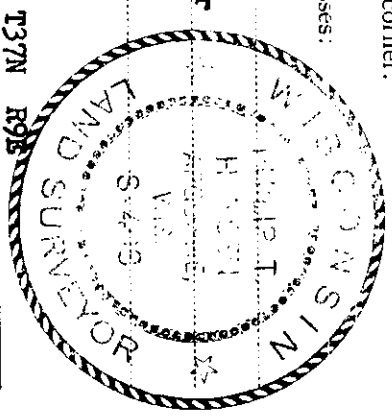

○ = Corner monument restored.

History of original corner establishment

Original Corner established by H.C. Fellows, Deputy Surveyor, in 1860, from which Spruce 6" bears S82°W 30 links; Spruce 10" bears N49°W 118 links; White Pine 1 1/4" bears N 67° E 21 links; Yellow Pine 1 1/4" bears S 18° E 37 links, N. Loftus, Ripco Surveyor, recovered this corner. Set 1 1/2" iron pipe with brass cap.

Description of corner evidence found:

Recovered 1 1/2" iron pipe with 4" brass cap stamped: Monument projects 36" above ground.  
Recovered OBT - Black Spruce 7" N18°E 17.4 links, scribed T37N R10E BT.  
No record of this BT.  
Monument leaning slightly.

T37N S13 | S18 T37N  
R9E S24 | S19 R10E

Description of monument and accessories I established to perpetuate the original location of this corner.

Reset monument to straighten it.  
NBT - Black Spruce 8" N2°E 30.4 links.  
Black Spruce 6" N70°W 28.0 links.  
Black Spruce 6" S5°W 65.5 links, all scribed SC BT.

Dated at Rhinelander, Wis., this 21st day of March, 1977.

Signature Phillip T. Hansen Title Registered Land Surveyor Registration No. S-498  
(County Surveyor, Registered Land Surveyor, or other duly authorized official)

Office of Register of Deeds, County of Oneida, I hereby certify that the within instrument was filed in this office for record on the 12th day of February, 1977 at 10:00 o'clock A. M.

Dorcas Wenzel Jackson  
(Register of Deeds)

By: \_\_\_\_\_ Deputy

3709130000