

CERTIFIED LAND CORNER RESTORATION

Index No. N-21

History of original corner establishment: Original Corner established by Wm. E. Dougherty, Deputy Surveyor, in 1863, from which Birch 12" bears S 78° W 27 links, Tamarack 10" bears N 82° E 34 links, Tamarack 12" bears N 73° W 12 links and Spruce 8" bears S 29° E 8 links.

N. Loftus, Ripco Surveyor, recovered this corner in 1956. Set a 2 1/2" iron pipe with 4" brass cap for corner.

Recovered OBTs. No records on file. Black Spruce 8" N 89° W 24.2 links, scribed BT, Balsam 6" S 75° E 30.5 links, scribed S24 BT.

Description of corner evidence found:  
Recovered 2 1/2" iron pipe with 4" square brass cap stamped:  
Monument leaning and poorly set.  
Recovered OBT - Black Spruce 8" N 89° W 24.2 links, scribed BT. T37N R9E S 14 1/2 13  
Balsam 6" S 75° E 30.5 links, scribed S24 BT. S 23 1/2 24  
Balsam is now a stump. RIPCO

Description of monument and accessories I established to perpetuate the original location of this corner.  
Removed monument and reset in same location.  
Monument now projects 36" above ground.  
Corner sets in a dense alder creek bottom.  
NBT - Black Spruce 10" N 38° E 55.8 links, scribed SC-BT.



State of Wisconsin } ss.  
County of Oneida

I Phillip T. Hansen, do hereby certify that on the 9th day of February, 1977, I found

evidence of the Section corner of Sec. 13, 14, 23, 24 Township 37 North, Range 9 East, Fourth Principal Meridian,

as described hereon; and that from this evidence I established a new monument and accessories as described hereon to perpetuate the original location of this corner.

Resident witnesses:  
Jim Claflin  
Herb Wagoner

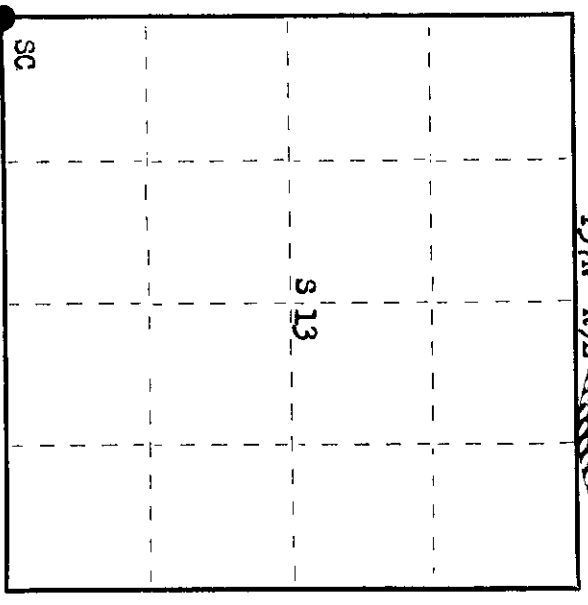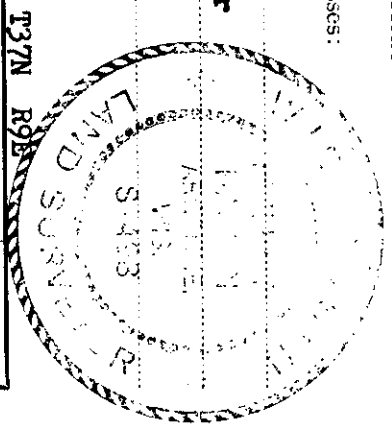

○ = Corner monument restored.

Dated at Rhinelander, Wis., this 16th day of March, 1977.

Signature: Phillip T. Hansen Title: Registered Land Surveyor Registration No. S-498  
(County Surveyor, Registered Land Surveyor, or other duly authorized official)

Office of Register of Deeds, County of Oneida, I hereby certify that the within instrument was filed in this office for record on the 23rd day of March, 1977 at 3:00 o'clock P. M.

Denise Verage Kuehn  
(Register of Deeds)

By: \_\_\_\_\_ Deputy

3709140000