

CERTIFIED LAND CORNER RESTORATION

Index No. **N-20**
370914001D

State of Wisconsin }
County of Oneida } ss.



I, Phillip T. Hansen, do hereby certify that on the 9th day of February, 1977, I found evidence of the E 1/16 corner of Section 14 and 23 Township 37, North, Range 9 East, Fourth Principal Meridian,

as described hereon; and that from this evidence I established a new monument and accessories as described hereon to perpetuate the original location of this corner.

Resident witnesses:

Jim Claflin

Herb Wagoner

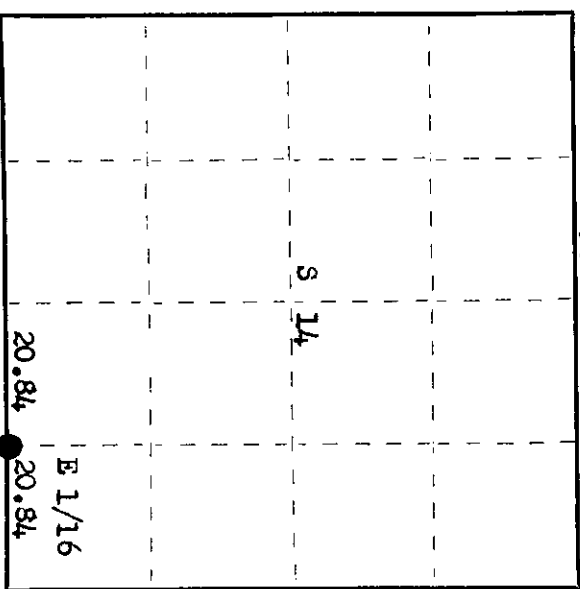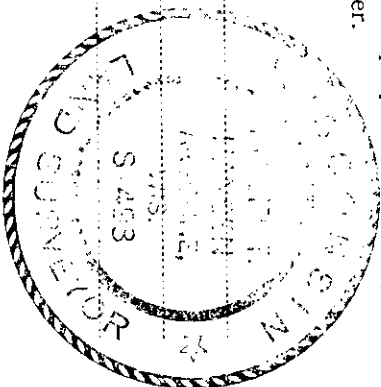

○ = Corner monument restored.

History of original corner establishment:

Corner established by N. Loftus, Ripco Surveyor, in 1955. Ran random line from S 1/4 corner S 86° 38' E a distance of 41.68 chains to close out 88 links south of old iron hub in creek bottom, accepted as being the section corner. Set E 1/16 corner at 20.84 chains intermediate and 4/4 links north. Corrected bearing S 87° 50' E. Set 1 1/2" iron pipe with brass cap and marked NBTs - White Pine 12" S 85° W 18 1/2 links and White Pine 8" N 18° E 87 links.

Description of corner evidence found:

Recovered 1 1/2" iron pipe with 2" square brass cap in good condition and securely in ground.
Monument projects 24" above ground. Cap stamped:
Recovered OBT - White Pine 12" S 85° W 18 1/2 links, now a stump. E 1/16 S 14
White Pine 8" N 18° E 87 links, now a dead stump. S 23

Description of monument and accessories I established to perpetuate the original location of this corner.

As monument was recovered in good condition, it was left in place.
Added stamping T37N R9E to brass cap.
NBT - Black Spruce 8" N 58° W 34.4 links, scribed 1/16 BT.
Maple 10" S 22° E 65.3 links, scribed 1/16 BT.

Dated at Rhineland, Wis., this 16th day of March, 1977.

Signature Phillip T. Hansen Title Registered Land Surveyor Registration No. S-498
(County Surveyor, Registered Land Surveyor, or other duly authorized official)

Office of Register of Deeds, County of Oneida. I hereby certify that the within instrument was filed in this office for record on the 23rd day of March, 1977 at 3:00 o'clock P. M.

Denise Verage Kuehn
(Register of Deeds)

By Denise Verage Kuehn Deputy