

State of Wisconsin

County of Oneida

ss.



I Phillip T. Hansen, do hereby certify that on the 11th day of February, 19 77, I found evidence of the Quarter corner of Section 14 & 23 Township 37, North, Range 9 East, Fourth Principal Meridian,

as described hereon; and that from this evidence I established a new monument and accessories as described hereon to perpetuate the original location of this corner.

Resident witnesses:

Jim Claflin

Herb Wagoner

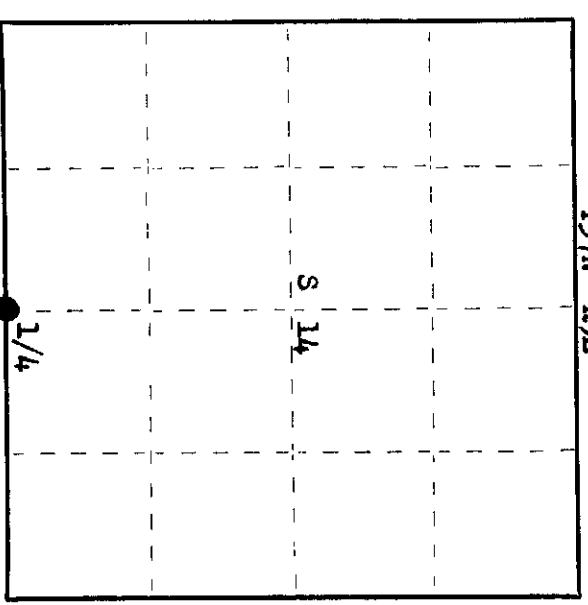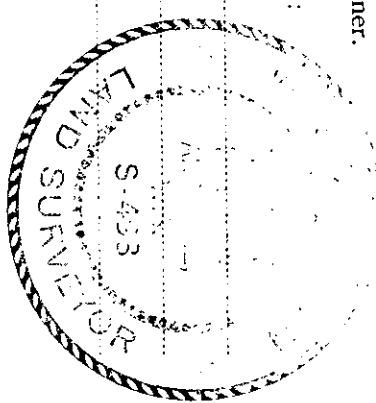

○ = Corner monument restored.

History of original corner establishment:

Original Corner established by Wm. E. Dougherty, Deputy Surveyor, in 1853, from which Hemlock 8" bears S 51° W 21 links and Birch 10" bears N 84° E 12 links. Corner re-established by D.H. Vaughan, County Surveyor. Corner recovered by N. Loftus, Ripco Surveyor, in 1955. Set iron pipe with brass cap and marked NBTs - Hemlock 12" N 55° W 8', Maple 6" N 87° E 21' and Cedar 6" S 35° E 26'.

Description of corner evidence found:

Recovered 2" iron pipe with 4" square brass cap in good condition and securely in ground.
Cap stamped:
Recovered OBT - Hemlock 12" (14") N 55° W 8' (12.5 lks.) scribed BT. T37N R9E
Maple 6" (8") N 87° E 21' (31.8 lks.) 1/4 11 4
Cedar 6" (8") S 35° E 26.0' (40.4 lks.), scribed S4 S14. 21 3
Hemlock 28" S 53° W 21.3 lks., scribing not legible. RIPCO

Description of monument and accessories I established to perpetuate the original location of this corner.
As monument was found in good condition and securely in ground, it was left in place.
Monument projects 30" above ground.
All distances measured to center of BT.

Dated at Rhineland, Wis., this 16th day of March, 19 77.

Signature Phillip T. Hansen Title Registered Land Surveyor Registration No. S-498
(County Surveyor, Registered Land Surveyor, or other duly authorized official)

Office of Register of Deeds, County of Oneida, I hereby certify that the within instrument was filed in this office for record on the 23rd day of March, 19 77 at 3:00 o'clock P. M.

Lorne George Kuehn
(Register of Deeds)

By: _____ Deputy