

CERTIFIED LAND CORNER RESTORATION

Index No. L-20

State of Wisconsin

County of Oneida } ss.

I, Phillip T. Hansen, do hereby certify that on the 9th day of April, 1980, I found evidence of the EC 1/16 corner of Section 14 Township 37 North, Range 9 East, Fourth Principal Meridian,


as described hereon; and that from this evidence I established a new monument and accessories as described hereon to perpetuate the original location of this corner.

Resident witnesses:


Glen Barker

Jim Clafin

Herb Wagoner

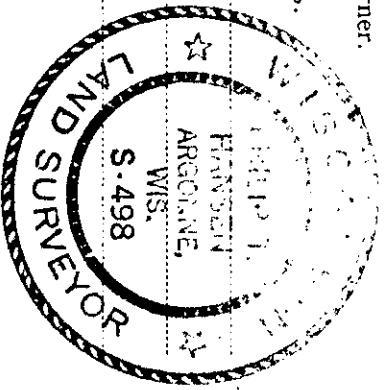

T37N R9E

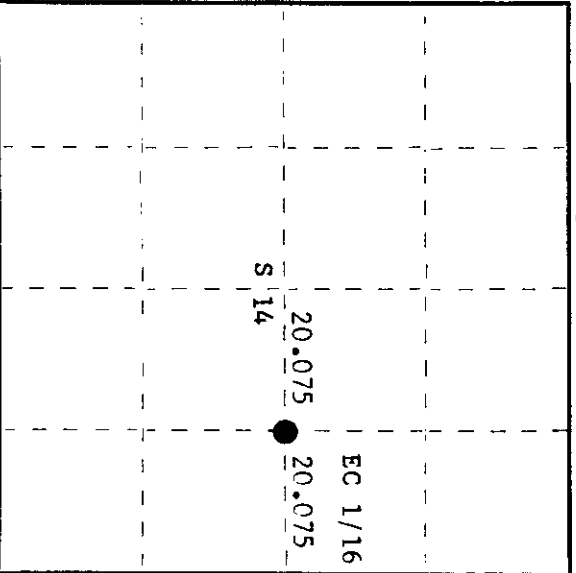

○ = Corner monument restored.

History of original corner establishment:

Corner set by Drivas and crew, Ripco surveyors, in 1962. Ran random line east from C 1/4 corner bearing N 89° 06' W 40.15 chains to close out 36.4 links south of E 1/4. They had previously recovered these corners and remonumented them in 1955. Set the EC 1/16 at 20.075 chains 18.2 links north. Corrected bearing S 89° 39' 10" E.

Marked NBT's -  
White Pine 10" S 10° E 23 links  
White Pine 16" S 74° E 48 links

Description of corner evidence found:

Recovered 1" iron pipe with alloy cap, not stamped, projecting 24" above ground in good condition.

Recovered OBT's -  
White Pine 10" (12") S10°E 23 links, scribed CE 1/16 BT.  
White Pine 16" (18") S74°E 48 links, scribed CE 1/16 BT.

Description of monument and accessories I established to perpetuate the original location of this corner.

Left monument in place.

Stamped cap -  
No additional accessories established.

T37N R9E  
S 14  
EC 1/16

1980

Dated at Rhineland, Wis., this 18th day of April, 1980

Signature: Phillip T. Hansen Title: Registered Land Surveyor Registration No. S-498  
(County Surveyor, Registered Land Surveyor, or other duly authorized official)

Office of Register of Deeds, County of Oneida, I hereby certify that the within instrument was filed in this office for record on the 16th day of May, 1980 at 11:10 o'clock A. M.

Doree Seeger Fuchs  
(Register of Deeds)

By: \_\_\_\_\_ Deputy

370914 2010