

CERTIFIED LAND CORNER RESTORATION

Index No. **K-19**

State of Wisconsin

County of **Oneida**

ss.



I **Phillip T. Hansen**, do hereby certify that on the **14th** day of **January**, 19 **77**, I found evidence of the **NC 1/16** corner of **Section 14**, Township **37**, North, Range **9 East**, Fourth Principal Meridian,

as described hereon; and that from this evidence I established a new monument and accessories as described hereon to perpetuate the original location of this corner.

Resident witnesses:

Jim Claitor

Herb Wagoner

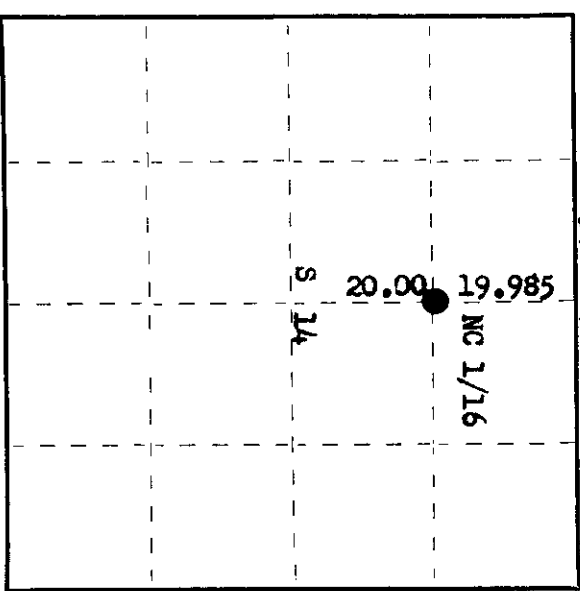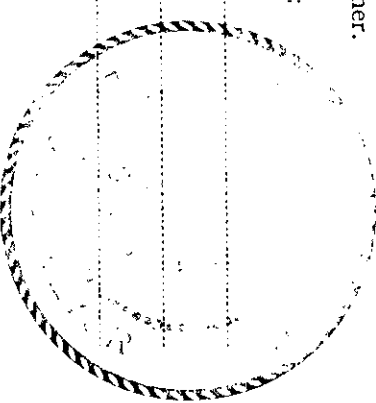

History of original corner establishment:

Corner established by N. Loftus and crew, Ripco Surveyors, in 1955. Ran a random line North from C 1/4 Corner, a recovered very old post, bearing N 80° E 39.985 chains to close out 75 links west of N 1/4 corner. At 20 chains North of C 1/4 found an old squared post marking the N-C 1/16, 37 1/2 links east of random. Set new iron pipe. Marked NBTs - Maple 7" N 50° E 33 links, Ash 6" S 62° W 44 links.

Description of corner evidence found:

Recovered 1 1/2" iron pipe with 2" square brass cap in good condition and firmly set in ground.
Recovered OBTs - Maple 7" N 50° E (N 42° E) 33.0 links, scribed BT, now a stump.
Black Ash 6" S 62° W 44.0 links, now dead. BT was never faced.


Description of monument and accessories I established to perpetuate the original location of this corner.

As monument was recovered in good condition, it was left in place.

Monument projects 24" above ground. Cap stamped:

NBTs - Black Spruce 8" N 52° E 45.4 links, scribed 1/16 BT.

Black Spruce 6" S 84° W, scribed 1/16 BT.

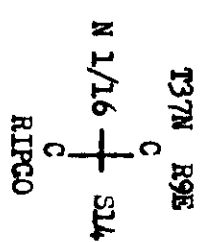

Dated at **Rhineland**, Wis., this **18th** day of **January**, 19 **77**.

Signature *Phillip T. Hansen* Title **Registered Land Surveyor** Registration No. **S-498**
(County Surveyor, Registered Land Surveyor, or other duly authorized official)

Office of Register of Deeds, County of **Oneida**
Instrument was filed in this office for record on the **24th** day of **February**, 19 **77**
at **1:00** o'clock **P.** M.

Dennis George Kuehn
(Register of Deeds)

By: _____ Deputy

3709143020