

CERTIFIED LAND CORNER RESTORATION



Index No. **N-15**

State of Wisconsin

County of Oneida } ss.

I, Philip T. Hansen, do hereby certify that on the 26th day of June, 1977, I found evidence of the Quarter corner of Section 15 & 22 Township 37, North, Range 9 East, Fourth Principal Meridian, as described hereon; and that from this evidence I established a new monument and accessories as described hereon to perpetuate the original location of this corner.

Resident witnesses:  
Jim Clafflin  
Herb Wagoner

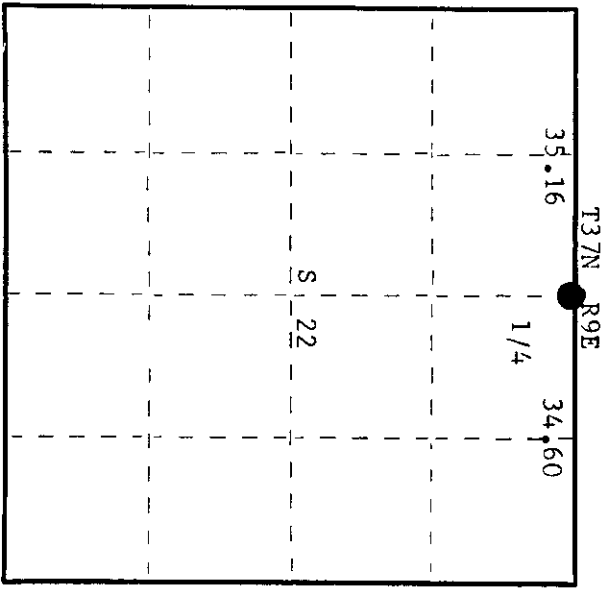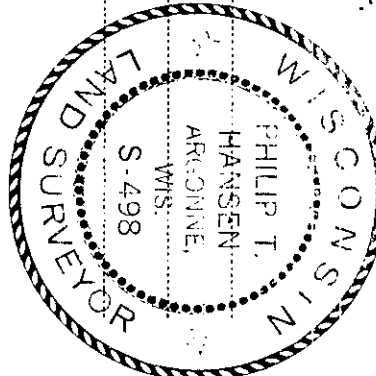

○ = Corner monument restored.

History of original corner establishment:

Original Corner established by Wm. E. Dougherty, Deputy Surveyor, in 1863 from which Tamarack 8" bears N38°W, 19 links and Tamarack 10" bears S17°E, 12 links. Corner recovered and restored by N. Loftus, Ripco Surveyor, in 1957 at 35.16 chains bearing N78°15'E. Set iron pipe and marked NBTs - White Birch 9" S21°W, 7 links and White Birch 9" N79°W, 26 1/2 links.

Description of corner evidence found:

Recovered 1-3/4" iron pipe with 3" square brass cap in good condition.  
Monument projects 30" above ground. Cap stamped:  
Recovered White Birch stump 9" S21°W, 7.0 links, scribed 1/4S BT.  
White Birch 9" N79°W, 26.5 links (27.2 lks.)  
Both trees had been cut above scribing.

T37N R9E  
1/4 S15 1/4  
RIPCO

Description of monument and accessories I established to perpetuate the original location of this corner.  
Monument left as recovered.

NBTs - Maple 8" N47°W, 48.2 links, scribed 1/4 BT.  
Maple 5" N87°E, 11.3 links, scribed 1/4 BT.  
Maple 5" N62°E, 37.0 links, scribed 1/4 BT.

Dated at Rhineland, Wis., this 29th day of June, 1977

Signature Philip T. Hansen Title Registered Land Surveyor Registration No. S-498  
County Surveyor, Registered Land Surveyor, or other duly authorized official)

Office of Register of Deeds, County of Oneida  
Instrument was filed in this office for record on the 26th day of June, 1977  
at 1:30 o'clock PM. I hereby certify that the within

By Doris Verage Kuehn (Register of Deeds)  
Joseph M. Brown Deputy

3709150020