

CERTIFIED LAND CORNER RESTORATION

Index No. E-17


State of Wisconsin

County of Oneida


ss.

I Phillip T. Hansen, do hereby certify that on the 11th day of February, 1977, I found evidence of the Quarter corner of Section 14, & 15 Township 37 North, Range 9 East, Fourth Principal Meridian, as described hereon; and that from this evidence I established a new monument and accessories as described hereon to perpetuate the original location of this corner.

Resident witnesses:
Jim Clafin
Herb Wagoner

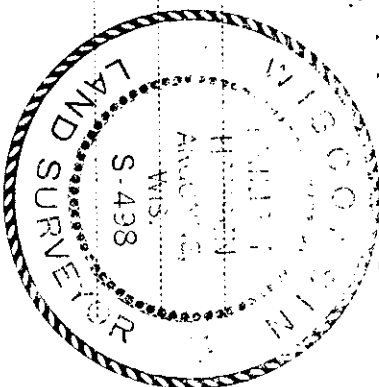

T37N R9E

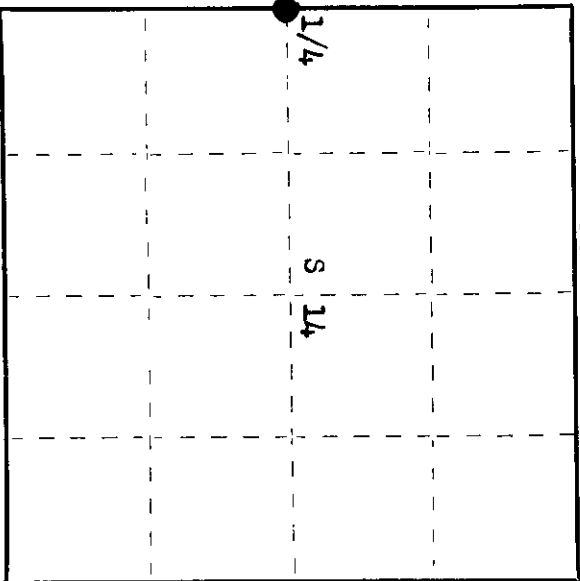

○ = Corner monument restored.

History of original corner establishment:

Original Corner established by Wm. E. Dougherty, Deputy Surveyor, in 1863, from which Aspen 7" bears N 30° E 18 links and Aspen 8" bears S 36° W 27 links.

Corner recovered in 1955 by N. Loftus, Ripco Surveyor. Ran random line south 10° W a distance of 76.73 chains to close out 2.745 chains east of corner. Searched for and found an old W 1/4 corner stake and BTs - Spruce 6" N 4° W 8 links and Spruce 5" S 41° W 4 links (dead).

Description of corner evidence found:

- Recovered 1 1/2" iron pipe with 4" square brass cap in good condition. Cap stamped: T37N R9E
- Recovered OBTS - Black Spruce 6" N 4° W 8 links, scribed 1/4 S BT, now stump.
- Black Spruce 5" S 41° W 4 links, now stump.
- Black Spruce 8" N 36° E 31.4 links, scribed 1/4 S S 14 BT. 1/4 S 15 1/4
- Black Spruce 6" N 4° W 48.0 links, scribed 1/4 S S 14 BT.
- Monument projects 24" above ground.

Description of monument and accessories I established to perpetuate the original location of this corner.

Monument being in good condition was left in place.
Marked NBT - Black Spruce 6" S 28° W 15.0 links, scribed 1/4 BT.

Dated at Rhinelander, Wis., this 17th day of March, 1977.

Signature Phillip T. Hansen Title Registered Land Surveyor Registration No. S-498
(County Surveyor, Registered Land Surveyor, or other duly authorized official)

Office of Register of Deeds, County of Oneida
Instrument was filed in this office for record on the 23rd day of March, 1977
at 3:00 o'clock P. M.

Dorrie Verne Kuehn
(Register of Deeds)

By: _____ Deputy

3709152000