


U.S. PUBLIC LAND SURVEY MONUMENT RECORD

Note: This form is intended and designed to fulfill all requirements of Wisconsin Administrative Code, Chapter A-E 7.08 U.S. Public Land Survey Monument Record (3) (a) (b) (c) (d) (e) (f) (g) (h) (i). An additional sheet may be added if necessary to conform with said requirements.

(a) Corner location: Township 37 North
 Range 9 East/West

Town/City/Village Pine Lake

County Oneida

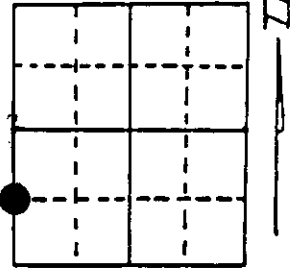

Section 15

(b) (f) (g) (h) Description of monument found at this corner and if it was accepted, state all evidence (material, testimonial, occupational, plats, records, other monuments) used as a basis for accepting. If not accepted or if nothing was found, state evidence used as basis for establishing location. If reestablished through lost corner proportionate methods, indicate all monuments, distances and directions used to establish. Indicate type of monument found or set and sign post.

12/5/1957 - RIPC0 surveyors set W.C. 35 links East of corner which falls in road.

Made two BTs:

8" Tamarack, S88°E, 71 Links (46.86')

9" Tamarack, S51°W, 1.005 Links (66.33')

6/26/1993 - Milo E. Stefan found W.C. as set by RIPC0/a 3/8" rod in road surface.


Both BTs by RIPC0 okay.

I made one new BT and set plastic sign post.

(c) (d) (e) Plan view of corner with ties to at least 4 witness monuments. If in disagreement with previously established corner, show the distances between the two corners and also indicate the ties to the disputed corner.

- 1) 3/8" iron rod in road surface.
- 2) 10" Tamarack, S88°E, 47.68'.
- 3) 10" Tamarack, S51°W, 65.80'.
- 4) 11" Tamarack, S39°W, 59.55'.
- 5) Witness Corner, East, 23.10'.
(1" x 18" high/2" x 2" brass cap)
- 6) Plastic sign post, East of W.C., 0.8'.

Distances to nail in side of BTs.
 Stump blaze scribed "BT".

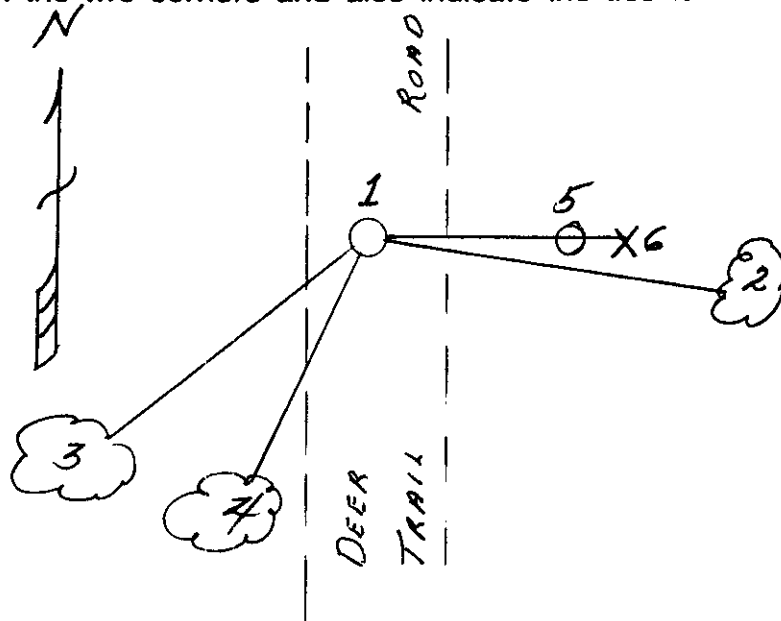

(i) I, Milo E. Stefan
 (type or print name) certify that the corner location on this record was determined by me or under my direction and control and that this U.S. Public Land Survey Monument Record is correct and complete to the best of my knowledge and belief.

Milo E. Stefan
 Signature

June 27, 1993
 Date



Index No. M-13

Stamp 3709161000