

CERTIFIED LAND CORNER RESTORATION

Index No. N-9

State of Wisconsin


County of Oneida } ss.

I Phillip T. Hansen, do hereby certify that on the 25th day of August, 1976, I found evidence of the Section corner of Sections 16, 17, 20, 21 Township 37 9 East, Fourth Principal Meridian, as described hereon; and that from this evidence I established a new monument and accessories as described hereon to perpetuate the original location of this corner.


Resident witnesses:

Jim Claffin

Herb Wagoner

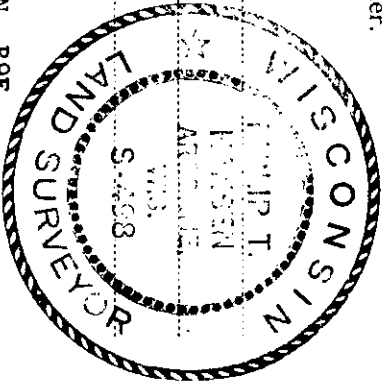

T37N R9E

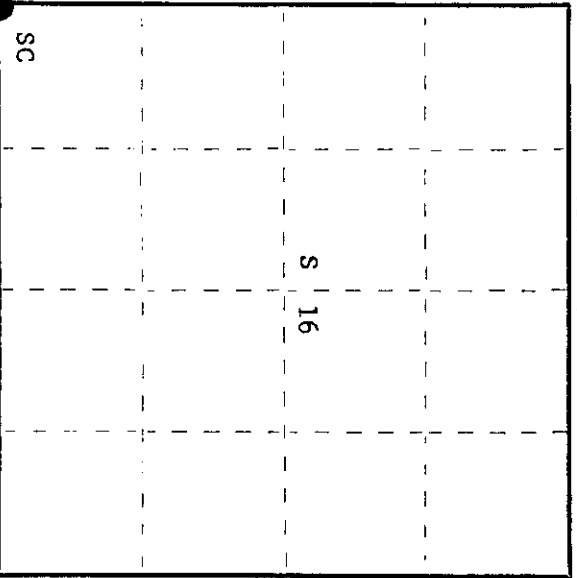

○ = Corner monument restored.

History of original corner establishment:

N. Loftus recovered a 2" iron pipe for section corner in 1961 when they ran the north line of section 20, east from a recovered N 1/4 corner. Marked NBT's - Black Spruce 4" S16°E 8-1/2 links Tamarack 5" N4°E 34-1/2 links Black Spruce 6" S86°E 33-1/2 links Set a new 2-1/2" iron pipe.

Description of corner evidence found:

Recovered Ripco's 2-1/2" iron pipe with alloy cap, stamped: Monument was loose in ground. Recovered an old iron pipe beside it.

T37N R9E
S17+ S16
S20+ S21
RIPCO

Recovered OBT's - Tamarack 5" (6") N4°E 34.5 links B.Spruce 6" (7") S86°E (N86°E) 33.5 links, scribed T37 R9E S21 B.Spruce 4" S16°E 8.5 links, scribed T37 R9E S21 (note error in bearing to BT #2)

Description of monument and accessories I established to perpetuate the original location of this corner.

Removed the iron pipe from the ground and put crossbar at end of it so it cannot be easily removed from ground. Marked NBT - B.Spruce 5" N70°W 25.3 links, scribed SC BT. Monument projects 20" above ground.

Dated at Rhineland, Wis., this 2nd day of January, 1980.

Signature: Phillip T. Hansen Title: Registered Land Surveyor Registration No. S-498
(County Surveyor, Registered Land Surveyor, or other duly authorized official)

Office of Register of Deeds, County of Oneida I hereby certify that the within instrument was filed in the office for record on the 11th day of February, 1980 at 2:15 o'clock P. M.

Donna Verage Tucker
(Register of Deeds)

By: _____ Deputy