

CERTIFIED LAND CORNER RESTORATION

Index No. **M-8**

State of Wisconsin

County of Oneida } ss.



I, Philip T. Hansen, do hereby certify that on the 22nd day of April, 1976, I found evidence of the SE 1/16 corner of section 17 Township 37 North, Range 9 East, Fourth Principal Meridian, as described hereon; and that from this evidence I established a new monument and accessories as described hereon to perpetuate the original location of this corner.

Resident witnesses:

Glen Barker

Jim Clarlin

Herb Jagoner

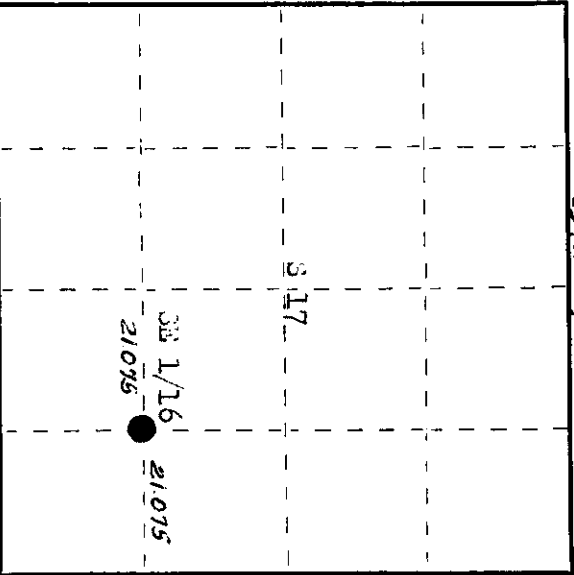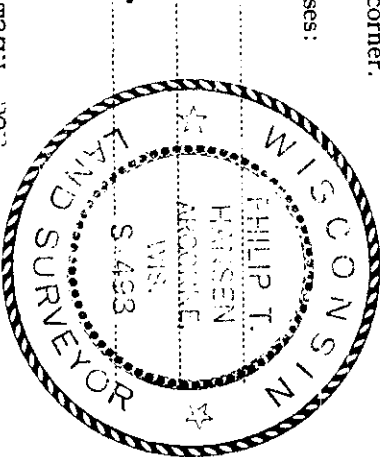

○ = Corner monument restored.

History of original corner establishment: Corner established by Drivas, Alpeco Surveyor, in 1902. A random line S 0° 25' 37" W from established BC 1/16, 42.15 chains to pt. 2 lks west of SE 1/16. Set SE 1/16 corner at 21.075 chains marked BPTs - Birch 5" N 40° W 46 lks, Oak 12" S 43° W 60-3/4 lks.

Description of corner evidence found: Recovered 1" iron pipe with aluminum cap stamped. Pipe projects 2' above ground. Recovered BPT - W. Birch 5" N 40° W (N 38° W) 46 lks, now a 12' stub, scribed SE 1/16 BPT. R. Oak 12" (16") S 43° W (S 58° W) 60.75 lks, scribed 1/16 STB BPT. S 17 Alpeco

Pipe in perfect condition. Description of monument and accessories I established to perpetuate the original location of this corner. As monument was recovered in good condition, it was left in place. Added T37N 49L station to cap. BPT - W. Birch 6" N 59° W 45 lks, scribed 1/16 BPT.

Dated at Rhinelander, Wis., this 13th day of July, 1976

 County Surveyor, Registered Land Surveyor, or other duly authorized official

Office of Register of Deeds, County of Oneida. I hereby certify that the within instrument was filed in this office for record on the 23rd day of July, 1976 at 1:00 o'clock P.M.

Alice Berge-Kuehn
 (Register of Deeds)

By: Deputy

3709171010