

CERTIFIED LAND CORNER RESTORATION

Index No. L-7

State of Wisconsin

County of Oneida } ss.

Phillip T. Hansen, do hereby

certify that on the 23rd day

of April, 1976, I found

evidence of the C 1/4

corner of Section 17

Township 37, North, Range

9 East, Fourth Principal Meridian,

as described hereon; and that from this evidence

I established a new monument and accessories



as described hereon to perpetuate the original

location of this corner.

Resident witnesses:

Jim Graftin

Herb Hagoner

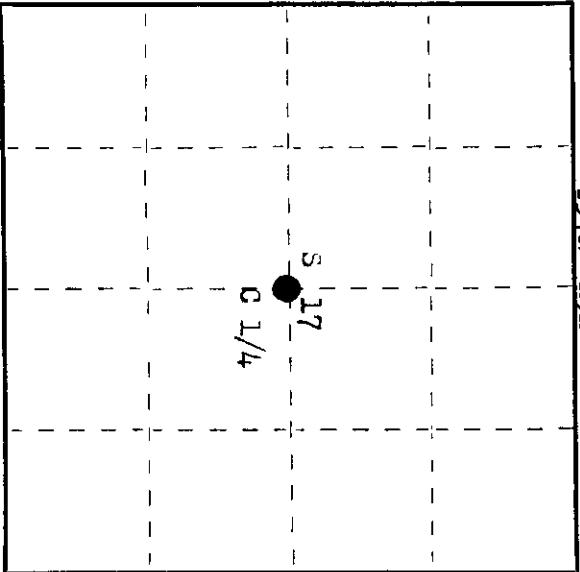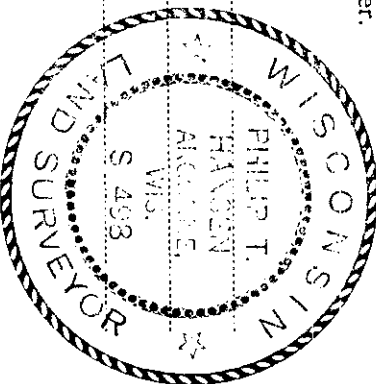

O = Corner monument restored.

History of original corner establishment: Corner established by Drivas, Ripco surveyor, in 1902. From established N 1/4 Corner he ran the E-W 1/4 line to W 1/4 corner. From W 1/4 corner he ran the N-S 1/4 line to N 1/4 corner. Established C 1/4 corner at 40.835 chains S 88° 19' 37" W of W 1/4 Corner and 2.50 chains North of S 1/4 corner. Set iron pipe with aluminum cap, but no record of BTs established.

Description of corner evidence found: recovered 2" iron pipe with aluminum cap stamped.

Pipe projects 24" above ground level. Recovered OBT - Tamarrack 8" W 88° W 93 lks, scribed C 1/4 S17 BT. T37N R9E

This tree is now dead. Spruce 3" S 80° W 24.4 lks, scribed C 1/4 S17 BT. C 1/4 S17 Ripco (now dead)

No record of these BTs in Ripco's notes. Also a 6" squared cedar post beside iron pipe, scribed C 1/4 1962 S17 Ripco S17 Drivas.

Description of monument and accessories I established to perpetuate the original location of this corner.

As the iron pipe was recovered in perfect condition, it was left in place.

Marked NETS - W Spruce 8" N 28° E 51.4 lks, scribed C 1/4 BT.

Cedar 8" S 85° W 23.0 lks, scribed C 1/4 BT.

ALL bearings and measurements made to iron pipe.

Dated at Rhinelander, Wis., this 13th day of July, 1976

Signature Phillip T. Hansen, Title Registered Land Surveyor, Registration No. 24498

Office of Register of Deeds, County of Oneida, I hereby certify that the within

instrument was filed in this office for record on the 3rd day of August, 1976

at 10:30 o'clock A. M. Doris Lorange Kuehn (Register of Deeds)

By: _____ Deputy

3709172020