

CERTIFIED LAND CORNER RESTORATION

Index No. N-5


3709180000

State of Wisconsin }  
County of Oneida } ss.


I Philip T. Hansen do hereby certify that on the 24th day of August, 1976, I found evidence of the section corner of 17, 18, 19, 20 Township 37 North, Range 9 West, Fourth Principal Meridian, as described hereon; and that from this evidence I established a new monument and accessories as described hereon to perpetuate the original location of this corner.

Resident witnesses:

Jim Claffin  
Herb Larson

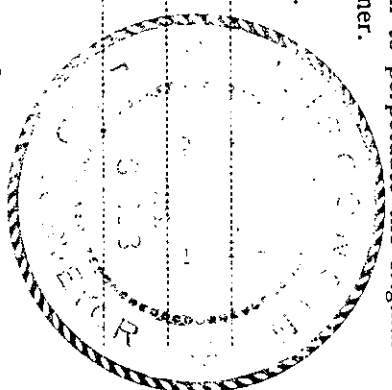

T37N R9E

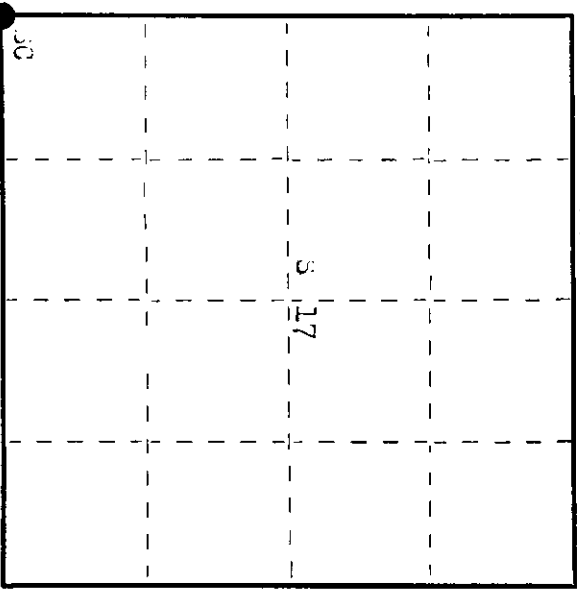

○ = Corner monument restored.

History of original corner establishment:

Original corner established by Wm. J. Dougherty, Deputy Surveyor, in 1865 from which Cedar 10" bears S 21° .. 15 links and Cedar 10" bears N 57° .. 13 links. Corner recovered by W. Loftus, Ripco Surveyor, in 1962. Set iron pipe, 2 1/2".

Description of corner evidence found:

Recovered 2 1/2" iron pipe with brass cap stamped:  
Corner projects 20" above ground.  
Recovered OBT's - Cedar 6" S 51° .. 10.6 links, scribed S 20, T37N R9E  
Cedar 10" N 28° .. 32.0 links, scribed T37N R9E S 17 ST.  
Cedar 8" S 77° .. 23.0 links, scribed S 17 T37N R9E ST.

Description of monument and accessories I established to perpetuate the original location of this corner. As this monument was recovered in excellent condition, it was left in place. Monument projects 20" above ground. OBT - Cedar 6" S 35° .. 31.4 links, scribed S 17 ST. All measurements to ST made to center of trees. Monument and OBT's painted blue.

Dated at Minnecander, Wis., this 9th day of September, 1976

Signature: Philip T. Hansen Title: Registered Land Surveyor Registration No. 2-428  
(County Surveyor, Registered Land Surveyor, or other duly authorized official)

Office of Register of Deeds, County of Oneida, Wis. I hereby certify that the within instrument was filed in this office for record on the 16th day of September, 1976 at 2:00 o'clock P.M.

Signature: David George Kuehn  
(Register of Deeds)

By: \_\_\_\_\_ Deputy