

CERTIFIED LAND CORNER RESTORATION

Index No. **M-5**

State of Wisconsin


County of Oneida } ss.

I, Phillip T. Hansen, do hereby certify that on the 24th day of August, 1976, I found evidence of the 3 1/16 corner of section 17 & 18 Township 37 North, Range 9 East, Fourth Principal Meridian, as described hereon; and that from this evidence I established a new monument and accessories as described hereon to perpetuate the original location of this corner.


Resident witnesses:

Jim Claflin

Herb Jagoner

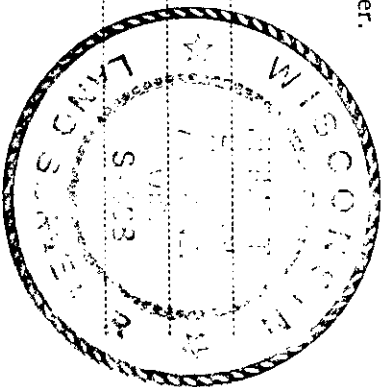

1377 1/2 R9E

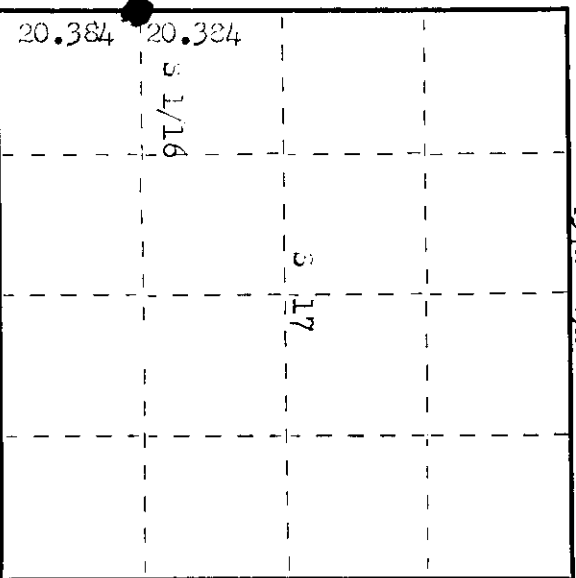

○ = Corner monument restored.

History of original corner establishment:

Corner established by H. Loftus, Ripco surveyor, in 1901. Ran random line S 0° 54' 20" W and at 75.5075 turned deflection angle 140° 35' 30" W. 0.15 chains to Section Corner 17, 18, 19, 20. Corrected bearing S 4° 18' 17" W. Corrected distance 61.538 chains.

Set 3 1/16 corner at 61.152 chains, 3.0255 chains west. Marked BT's - white pine 20" N 72° W 96 links and white pine 7" S 32° W 22 1/2 links.

Description of corner evidence found:

Recovered Ripco's 3/4" iron pipe with alloy cap stamped.

Recovered OBT - white pine 20" (24") S 72° W (N 06° W) 96.0 links scribed 3 1/16 BT white pine 7" (9") S 32° W (S 38° W) 22.5 links, scribed 3 1/16 BT

Pipe appeared in good condition, but was loose in ground.

3 1/16  
18 1/2  
ALPCO

Description of monument and accessories I established to perpetuate the original location of this corner. removed pipe from ground, installed crossbar and set it back in same location. added staking 1377 1/2 R9E to cap. monument projects 30" above ground. monument and BT's painted blue.

Dated at Oneida, Wis., this 3rd day of September, 1976

Signature Phillip T. Hansen Title Registered Land Surveyor Registration No. 498  
(County Surveyor, Registered Land Surveyor, or other duly authorized official)

Office of Register of Deeds, County of Oneida, I hereby certify that the within instrument was filed in this office for record on the 28th day of September, 1976, at 1:00 o'clock P. M.

Anna Bernice Kuehn  
(Register of Deeds)

By \_\_\_\_\_ Deputy

3709181000