


U. S. PUBLIC LAND SURVEY MONUMENT RECORD

INSTRUCTIONS: This record shall show the location of the corner and shall include all of the following nine elements (a through i).

- (a) Identify the corner by reference to the U.S. public land survey system.

● = Corner monument restored.

**NORTH 1/4 CORNER
SECTION 30,
TOWNSHIP 37 NORTH,
RANGE 9 EAST,
ONEIDA COUNTY, WISC.**

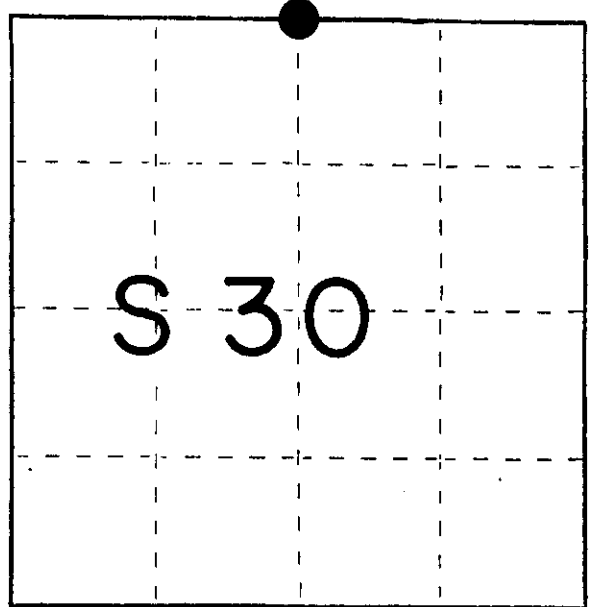

Compared with all record data and accepted as correct.


Robert H. Kowak 18 JAN 84
Oneida County Surveyor date

- (b) Describe any record evidence, monument evidence, occupational evidence, testimonial evidence or any other material evidence you considered, and whether the monument was found or placed.

Original corner by Wm. Daugherty in 1865. East between 19 & 30, 42.00 set post. BT's Y Pine 14" N59W 17 lks, Y Pine 14" S29W 8 lks. DH Vaughan at corner March 1909. He found original stumps and set post in fence corner. We check his distance south to C₁. J.C. Kirby at corner in 1966. He found an iron pipe. W.E. Bandow at corner in August 1978. J. Kasson found 1½" iron pipe at corner in Oct., 1982. He made 3 BT's Oak 10" N13W 9.30', N. Pine 13" S17E 10.06', Maple 9" N89W 43.59'. Dist. are to PK nails in face blaze. I found 1½" iron pipe and Kasson's BT's. Made one new BT. Maple 5" N84E 12.52' to 6" spike in approximate center of tree.

- (c) In the plan view drawing below, provide reference ties to at least 4 witness monuments, or, if the location is within a municipality, to at least 2 witness monuments. (Witness monuments shall be made of concrete, natural stone, iron or other equally durable material.)
Describe witness monuments.

- (d) Show a plan view drawing depicting the relevant monuments and reference ties which is sufficient in detail to enable accurate relocation of the corner monument if the corner monument is disturbed. Indicate north.

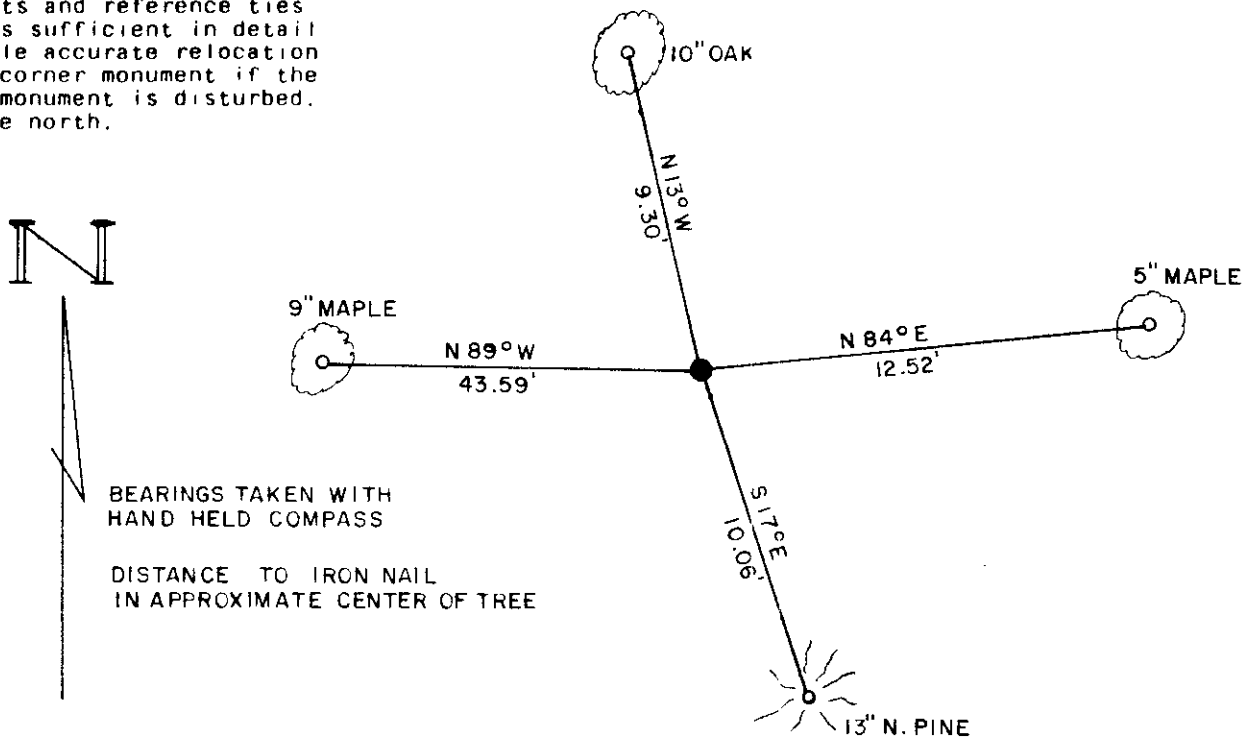

R-3

3709190020

(e) Describe any material discrepancy between the location of the corner as restored or reestablished and the location of that corner as previously restored or reestablished by distance and direction. Show the discrepancy on the plan view drawing under (d), above. Show the distances between the corner as previously restored or reestablished and (1) the corner as restored or reestablished, and (2) to at least 2 of the witness monuments shown on the drawing in (d), above.

NONE

(f) Was the corner restored through acceptance of (1) an obliterated evidence location, or, (2) a found perpetuated location?

Found perpetuated location.

(g&h) Was the corner reestablished through lost corner proportionate methods? If so, show the method, including the directions and distances to other public land survey corners used as evidence or used for proportioning in determining the corner location?

No.

REGISTRARS OFFICE

Received for record the 18th day of
January A.D. 1984 at
10 o'clock A M. and recorded in
Vol. _____ on page _____

Louis Verage Kuehn
Registrar

Affix Land Surveyor Seal



(1) I, William E. Bandow
(type or print name) certify that the corner location shown on this record was determined by me or under my direction and control and that this U.S. Public Land Survey Monument Record is correct and complete to the best of my knowledge and belief.

William E. Bandow 10-18-83
Signature Date