

CERTIFIED LAND CORNER RESTORATION

Index No. P-5

State of Wisconsin }
County of Oneida } ss.

I, Philip T. Hansen, do hereby certify that on the 14th day of April, 1976, I found evidence of the quarter corner of Section 19 and 20 Township 37, North, Range 9 East, Fourth Principal Meridian, as described hereon; and that from this evidence I established a new monument and accessories as described hereon to perpetuate the original location of this corner.

Resident witnesses:

Glen Barker

Jim Claflin

Herb Wagoner




History of original corner establishment: Original Corner established by Wm. B. Dougherty, Deputy Surveyor, in 1863, from which Red Oak 10" bears S 85° E 24 lks and Birch 10" bears S 58° W 31 lks.
Corner recovered and re-established by D.H. Vaughan.
Corner recovered by MIPCO Surveyors, Goddard and Drivas in 1961. Recovered old post and BT. Set new iron pipe with aluminum cap and marked NBTs - Maple 6" S 7° W 52 lks and Maple 4" S 84° W 38 lks.

Description of corner evidence found: Recovered 2" iron pipe with aluminum cap stamped. Monument projects 12" above ground.
Recovered NBTs - Maple 6" S 7° W 52 lks, faced but not scribed.
Maple 4" (5") S 84° W (N 86° W) 38 lks (37.5 lks), faced but not scribed.
Fire scarred pine stump, N 14° W 28.2 lks.
Corner monument recovered in perfect condition.

T37N R9E
1/4
S19 | S20
MIPCO

Description of monument and accessories I established to perpetuate the original location of this corner.
As monument was in perfect condition, it was left as found.
NBT - Maple 8" S 67° E 104.5 lks, scribed 1/4 BT.
Monument and BTs painted blue.

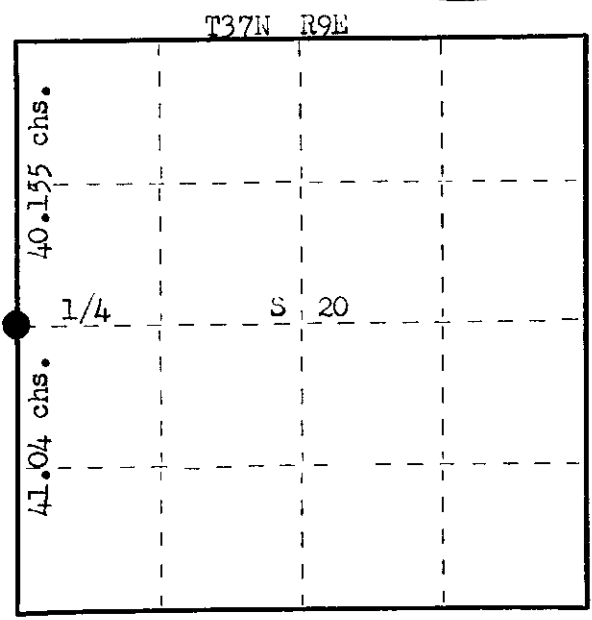

○ = Corner monument restored.

Dated at Rhineland, Wis., this 16th day of August, 1976

Signature Philip T. Hansen Title Registered Land Surveyor Registration No. S-498
(County Surveyor, Registered Land Surveyor, or other duly authorized official)

Office of Register of Deeds, County of Oneida, I hereby certify that the within instrument was filed in this office for record on the 22nd day of September, 1976 at 1:00 o'clock P. M.

Doris Terage Kuehn
(Register of Deeds)

By.....Deputy

FORM 985 H. C. MILLER CO., MILWAUKEE

0007616015