CERTIFIED LAND CORNER RESTORATION

Index No. 0-5

37091936000

State of Wisconsin } ss.
County of Oneida

I Philip T. Hansen, do hereby certify that on the 26th day of August, 1976, I found evidence of the N 1/16 corner of Section 19 and 20 Township 37, North, Range 9 East, Fourth Principal Meridian, as described hereon; and that from this evidence I established a new monument and accessories as described hereon to perpetuate the original location of this corner.

Resident witnesses:

Jim Claflin

Herb Wagoner

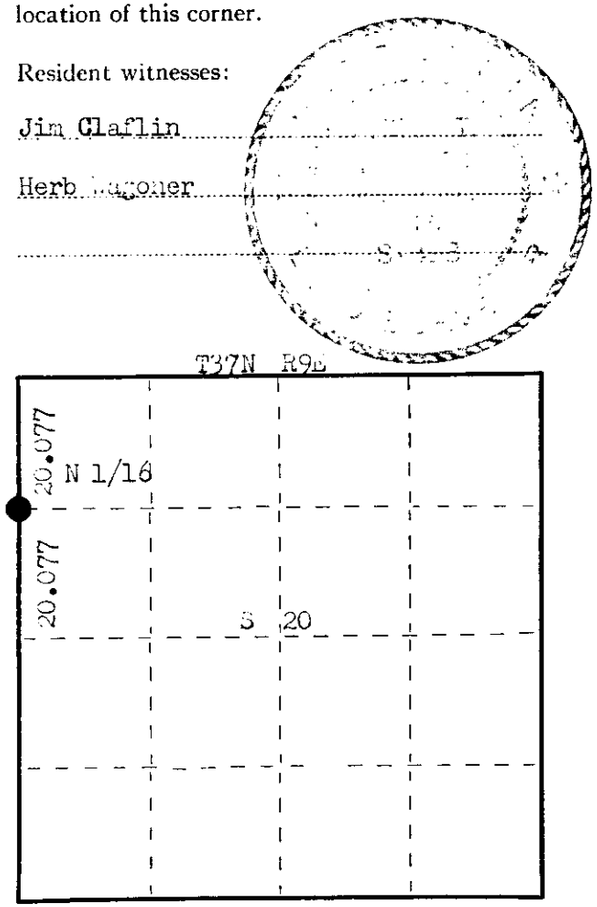

○ = Corner monument restored.

History of original corner establishment:
Corner established by L. Loftus, Ripco Surveyor, in 1901.
From previously restored N 1/4 corner, ran random line bearing 2° 15' mag. 40.15 chains, closed out 2.00 chains west of Section Corner. Set N 1/16 at 20.0775 chains, equidistant, 1.00 chain east. Marked Red Pine 6" S 12° E 48½ links and Red Pine 10" S 78° E 68 links. Corner set on edge of beach near water line.

Description of corner evidence found:
Recovered 1" iron pipe with alloy cap stamped N 1/16 - RIPCO. Also a 5" squared cedar post laying down in water beside pipe, scribed N 1/16 S19, N 1/16 S20. The corner sets in water on east edge of South Pine Lake. Monument recovered in good condition.
Recovered OBT's - Red Pine 10" (12") S 78° E 68 links, scribed N 1/16 S20 BT.
Red Pine 6" (8") S 12° E 48.5 links, scribed N 1/16 BT.

Description of monument and accessories I established to perpetuate the original location of this corner.
Reset monument deeper into floor of lake. Water depth here is approximately 5".
Added scribing to alloy cap, now stamped:
Monument projects 12" out of water.
Set 1" iron pipe with 2" brass cap for witness corner, S 45° E 45.0 links, cap stamped. Projects 24" above ground.
Witness Corner and OBT's painted blue.
No additional accessories established.

T37N R9E
N 1/16
S19 | S20
RIPCO

S498
N 45° W
W | C
45 lks to Cor.
OBI - 1976

Dated at Rhinelander, Wis., this 10th day of September, 1976

Signature Philip T. Hansen Title Registered Land Surveyor Registration No. S-498
(County Surveyor, Registered Land Surveyor, or other duly authorized official)

Office of Register of Deeds, County of Oneida, I hereby certify that the within instrument was filed in this office for record on the 9th day of November, 19 76 at 10:30 o'clock a M.

Erma Verage Kuehn
(Register of Deeds)

By ..... Deputy

FORM 985 W. C. MILLER CO., MILWAUKEE