

CERTIFIED LAND CORNER RESTORATION

Index No. **R-6**

State of Wisconsin

County of Oneida } ss.


I Phillip T. Hansen do hereby certify that on the 27th day of August, 1976, I found evidence of the 1/16 corner of section 20 and 29 Township 37 North, Range 9 East, Fourth Principal Meridian.

Resident witnesses:
Jim Martin
Mark ...

History of original corner establishment: Corner established by H. Loftus, at 100 curve of, in 1901. Ran a random line 28° 30' magnetic from S 1/4 corner section 19 21.14 chains, closer out 3.0525 chains south of S 1/4 corner section 20. Corrected true length of 1.197 chains, corrected bearing is 86° 11' ...
Set on 1/16 sec. 20-29 at 61.48 chains 1.953 chains south of offset random line. Marked with 3 spruce 3" x 270 ... 27.4 links, 5 spruce 3" x 260 ... 32.5 links. Set iron pipe.

Description of corner evidence found:
Recovered iron pipe 1" OD with alloy cap, stamped:
Pipe was bent and driven into ground.
Recovered bolts - Spruce 3" (8") x 270 ... (S 30° W) 27.4 links, .. 1/16 2/20
scribed on 1, 15 29 RT.
Spruce 3" x 260 ... 32.5 links, low used ... down. RIFCO

Description of monument and accessories I established to perpetuate the original location of this corner.
Replaced damaged iron pipe with 1" OD iron pipe with 2" brass cap, stamped:
Monument projects 3" above ground.
NIP - 44, 10 29 24 2 7.0 links, scribed 1/16 RT.
Monument and NIP painted blue.
.. 1/16 2/20
Or 1-1976

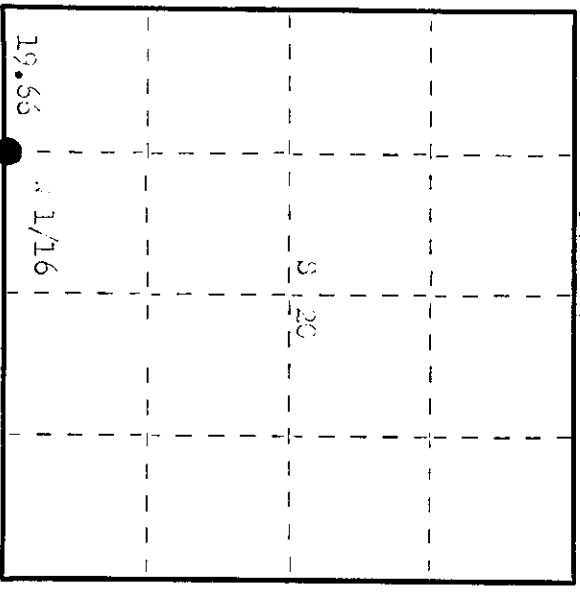

○ = Corner monument restored.

Dated at Oneida, Wis. this 15th day of September, 1976

Signature: *Phillip T. Hansen* Title: Registered Land Surveyor
Office of Register of Deeds, County of Oneida
Instrument was filed in this office for record on the 9th day of December, 1976 at 10:30 o'clock A.M.

Signature: *Dora Truog Kuehn* (Register of Deeds)
I hereby certify that the within instrument was filed in this office for record on the 9th day of December, 1976 at 10:30 o'clock A.M.

By: _____ Deputy

370920030